

TOTAL SF AVAILABLE -6,306 RSF



OFFICE - 3,596 RSF

WAREHOUSE - 2,710 RSF

* INCLUDES % OF METER ROOM

[Click to access CADD file](#)

Key Plan

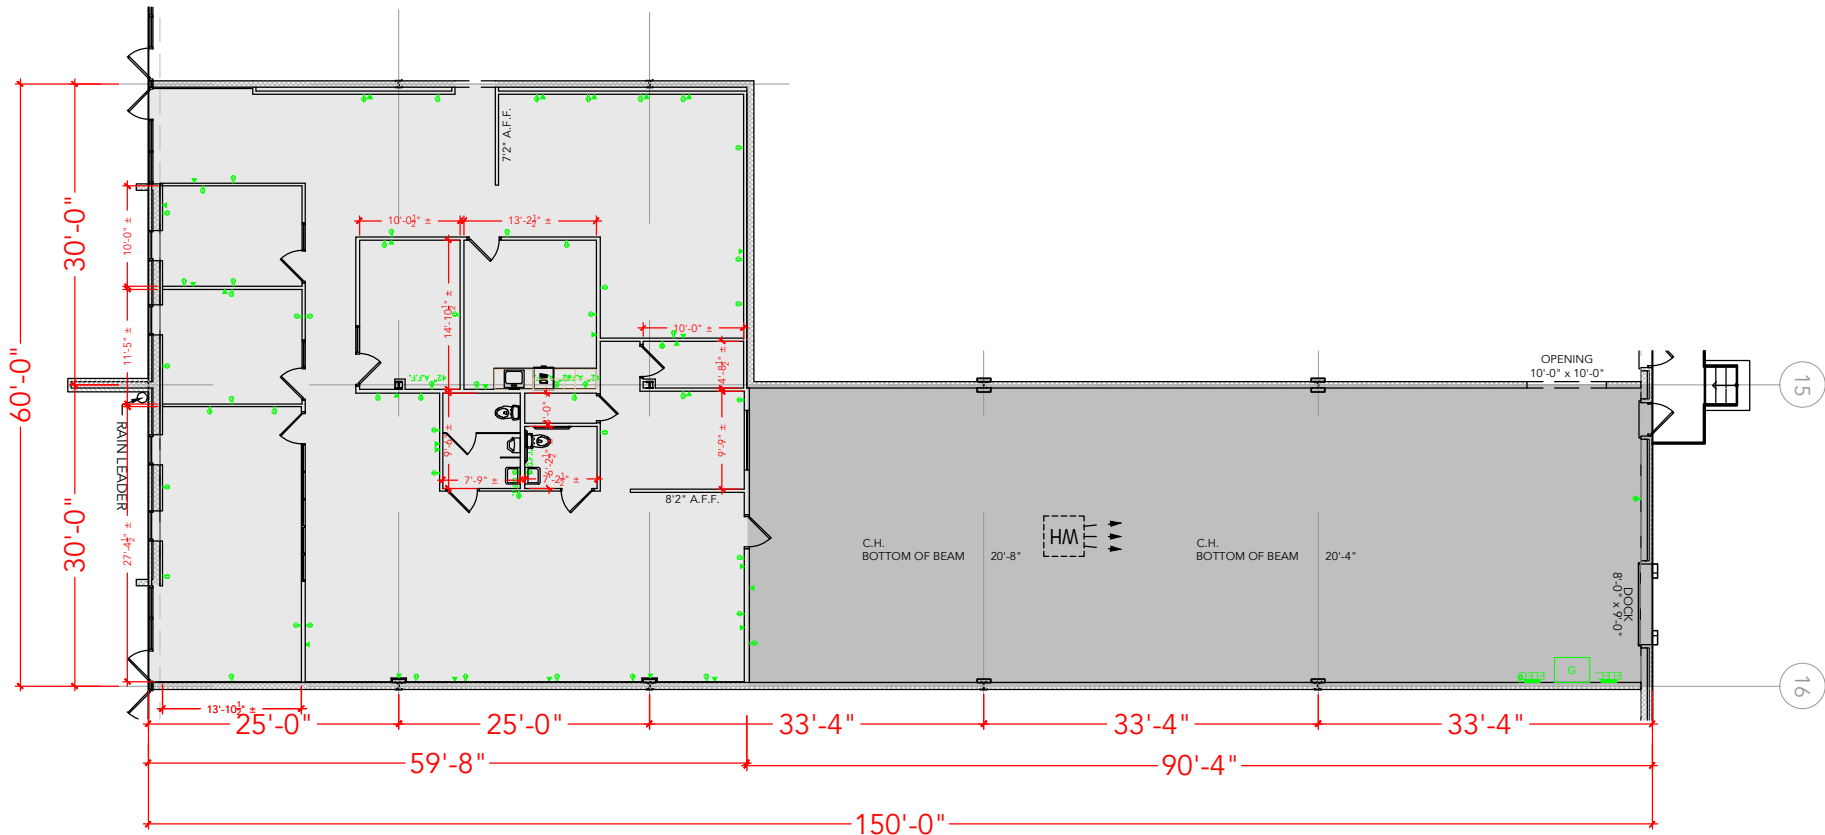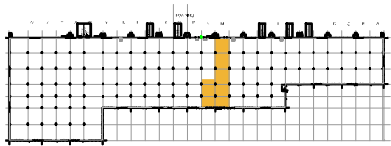

Floor Plan