


HIDDEN ROCK I

9305 GERWIG LANE COLUMBIA, MD 21046
SUITE M-P


TOTAL SF AVAILABLE -13,500 SF

OFFICE - 7,547 SF
WAREHOUSE SF - 5,953 SF

[Click to access 3D model](#)

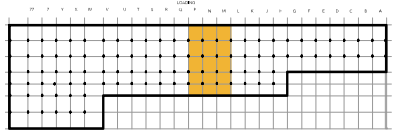

Key Plan

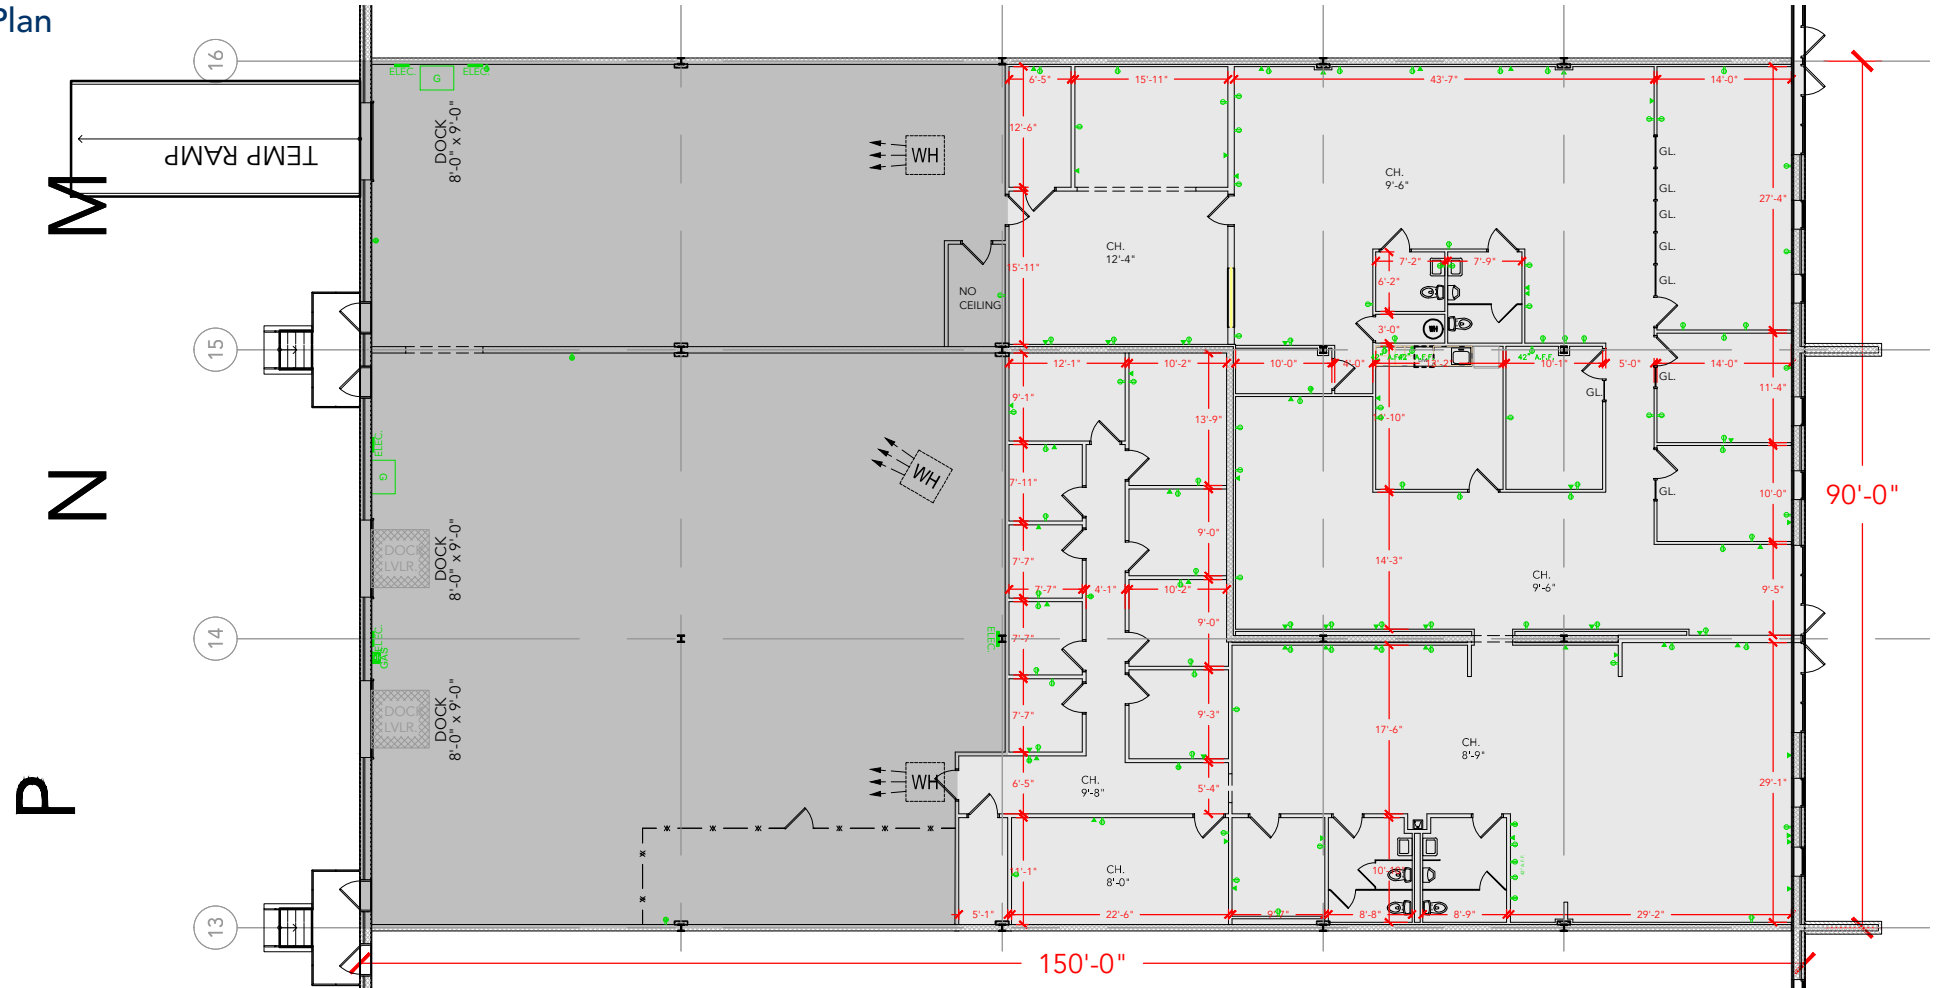

Floor Plan