


TOTAL SF AVAILABLE -7,216 RSF

OFFICE - 1,790 RSF


WAREHOUSE - 5,426 RSF

* INCLUDES % OF METER ROOM

[Click to access CADD file](#)

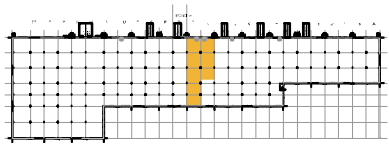

Key Plan

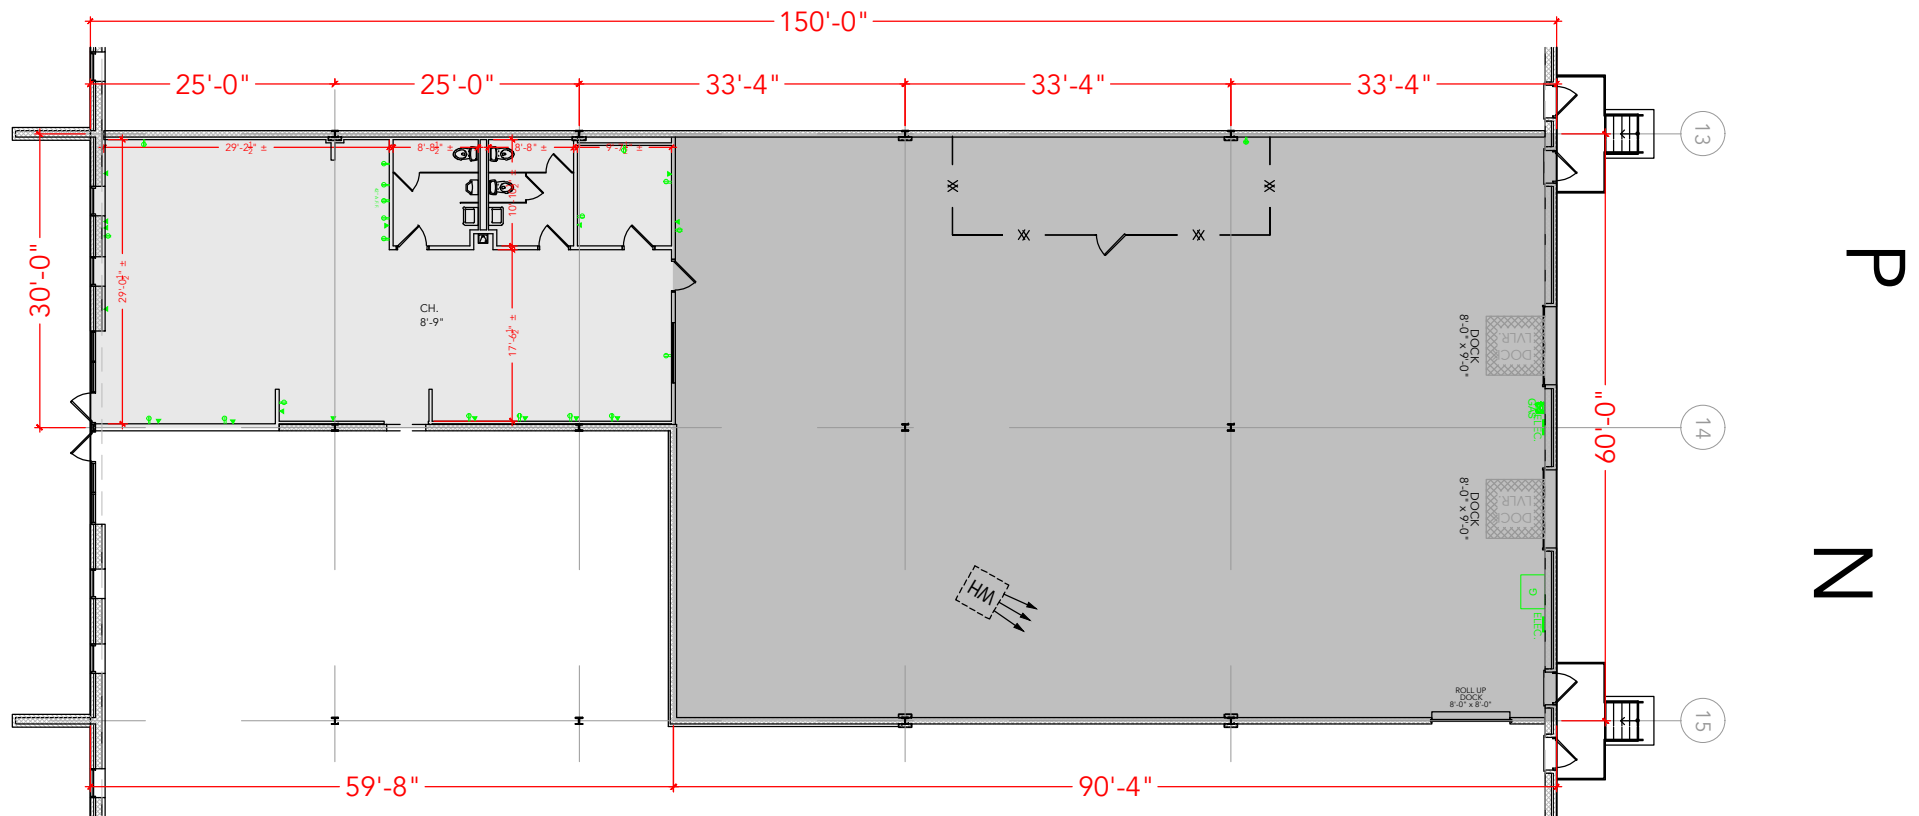

Floor Plan