


TOTAL SF AVAILABLE -7,205 RSF

OFFICE - 1,791 RSF


WAREHOUSE - 5,414 RSF

* INCLUDES % OF METER ROOM

[Click to access CADD file](#)

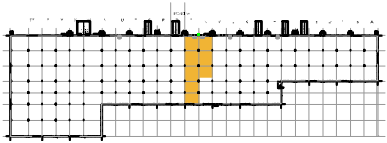

Key Plan

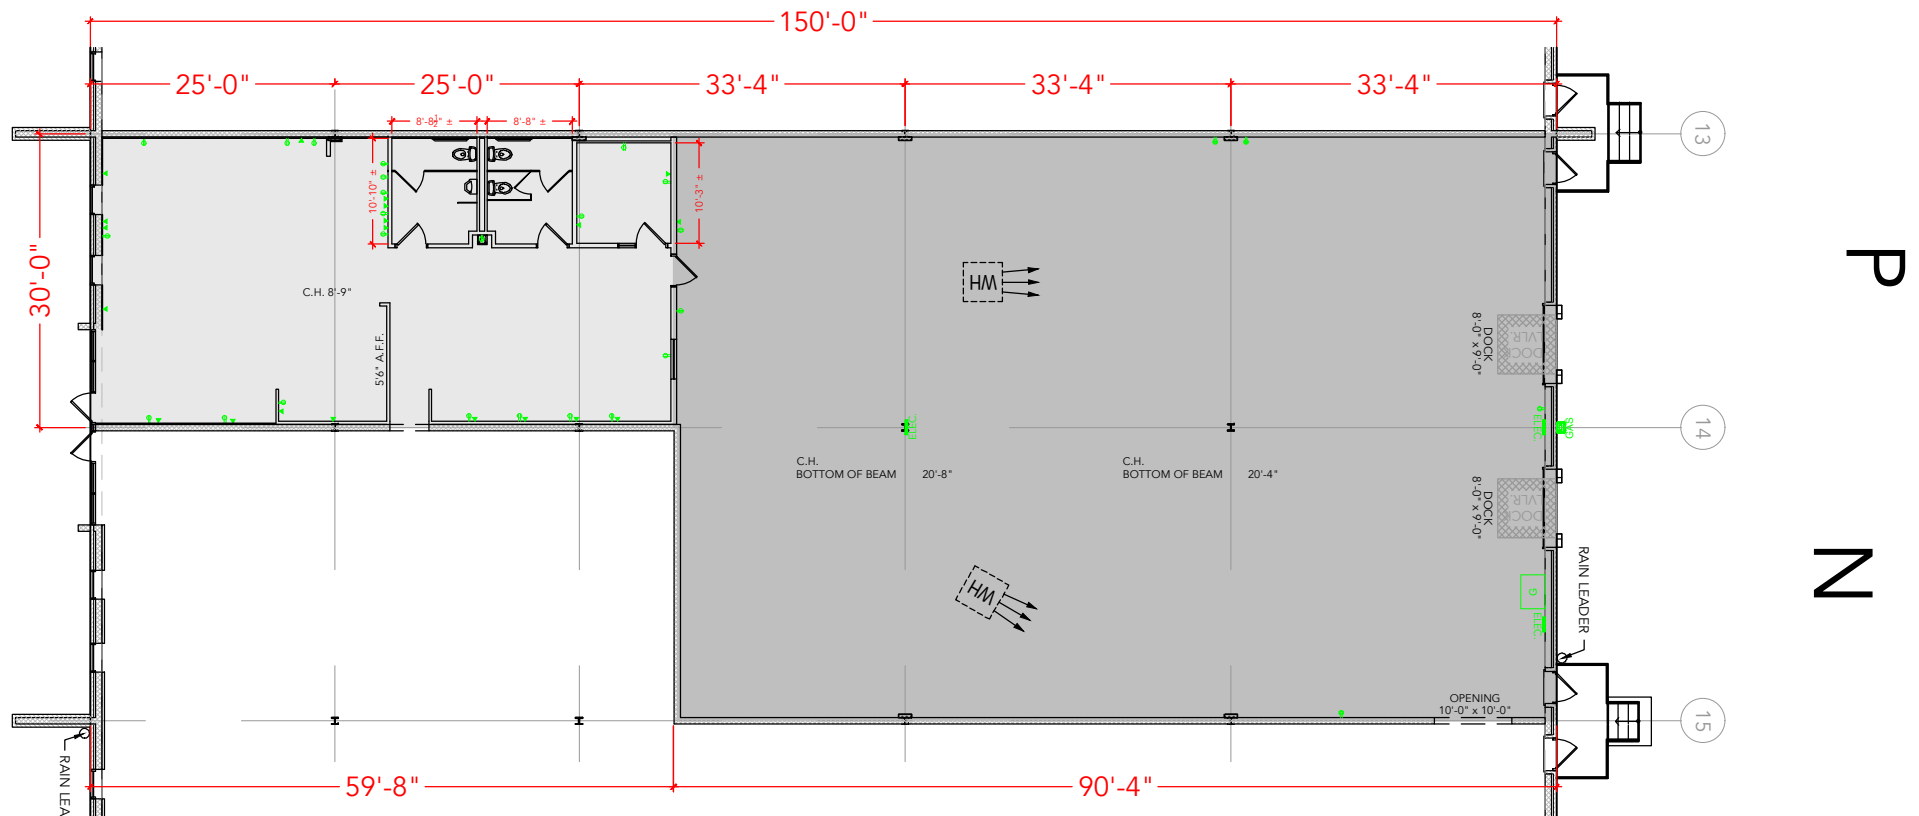

Floor Plan