

HIDDEN ROCK II

9515 GERWIG LANE COLUMBIA, MD 21046


SUITE 105-106

TOTAL SF AVAILABLE - 6,900 SF


OFFICE - 3,345 SF

WAREHOUSE - 3,555 SF

[Click to access 3D model](#)

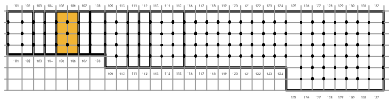

Key Plan

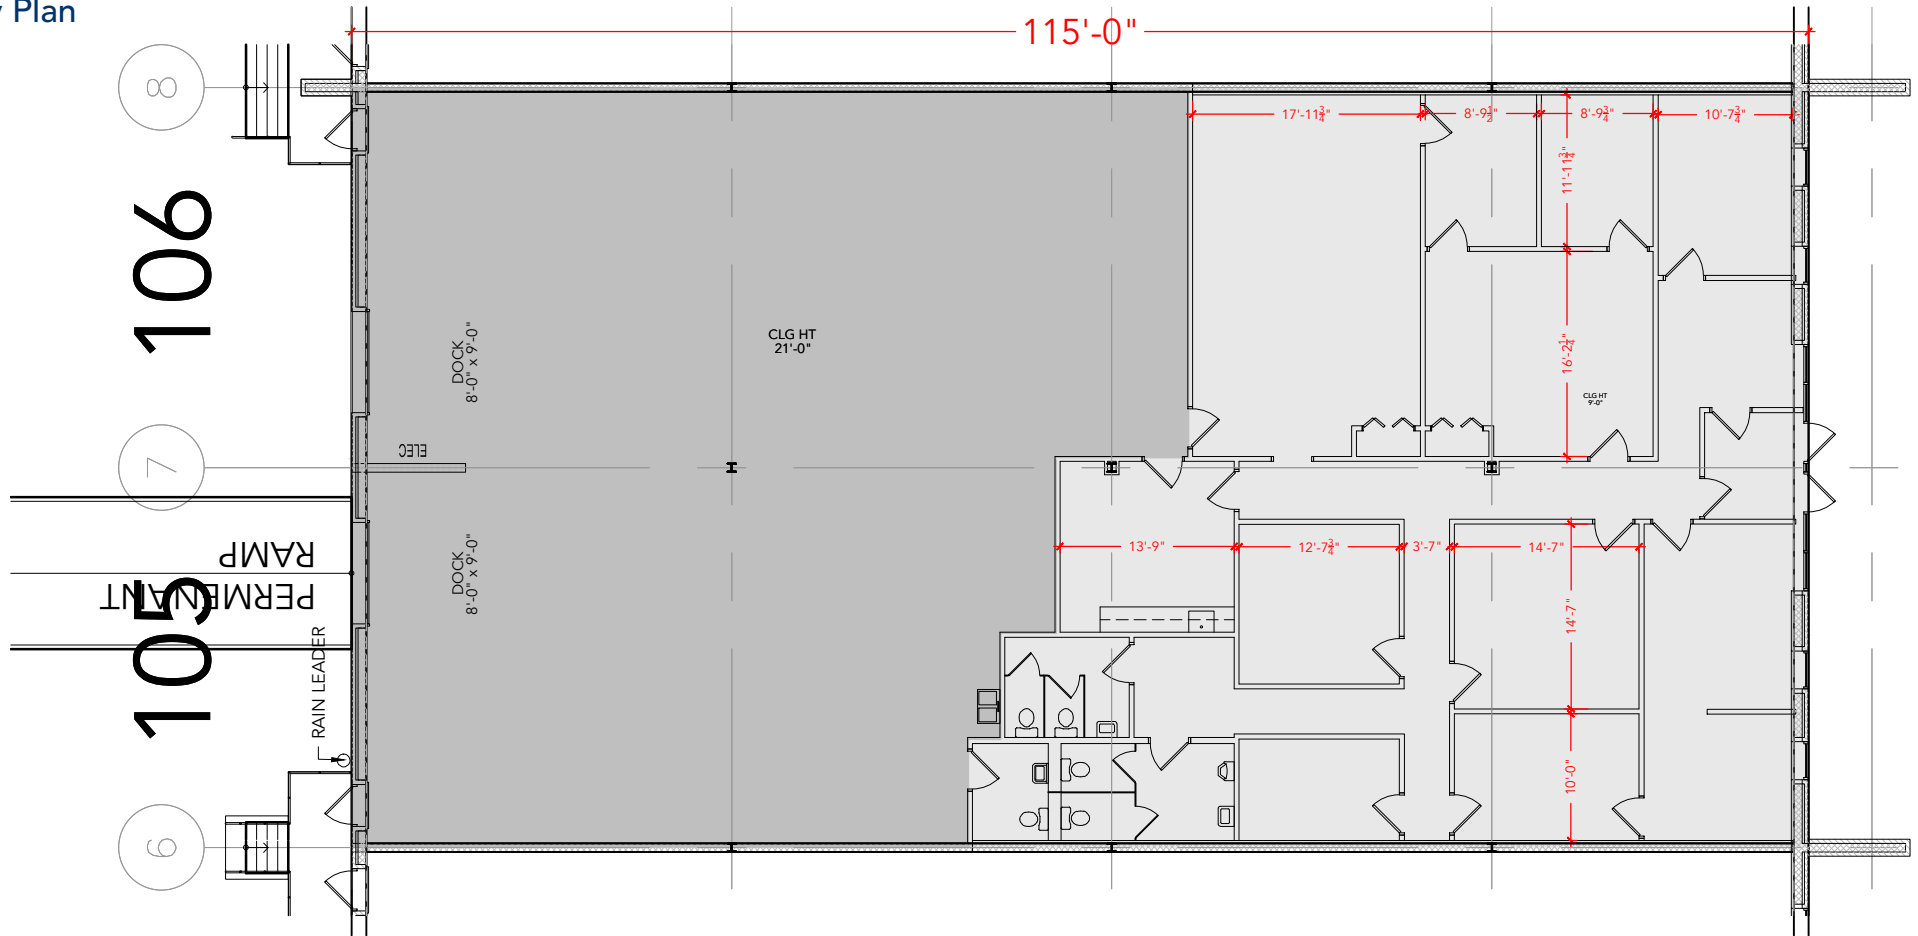

Floor Plan