


TOTAL SF AVAILABLE - 6,900 SF


OFFICE - 3,499 SF

WAREHOUSE - 3,401 SF

[Click to access 3D model](#)

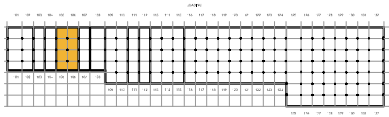

Key Plan

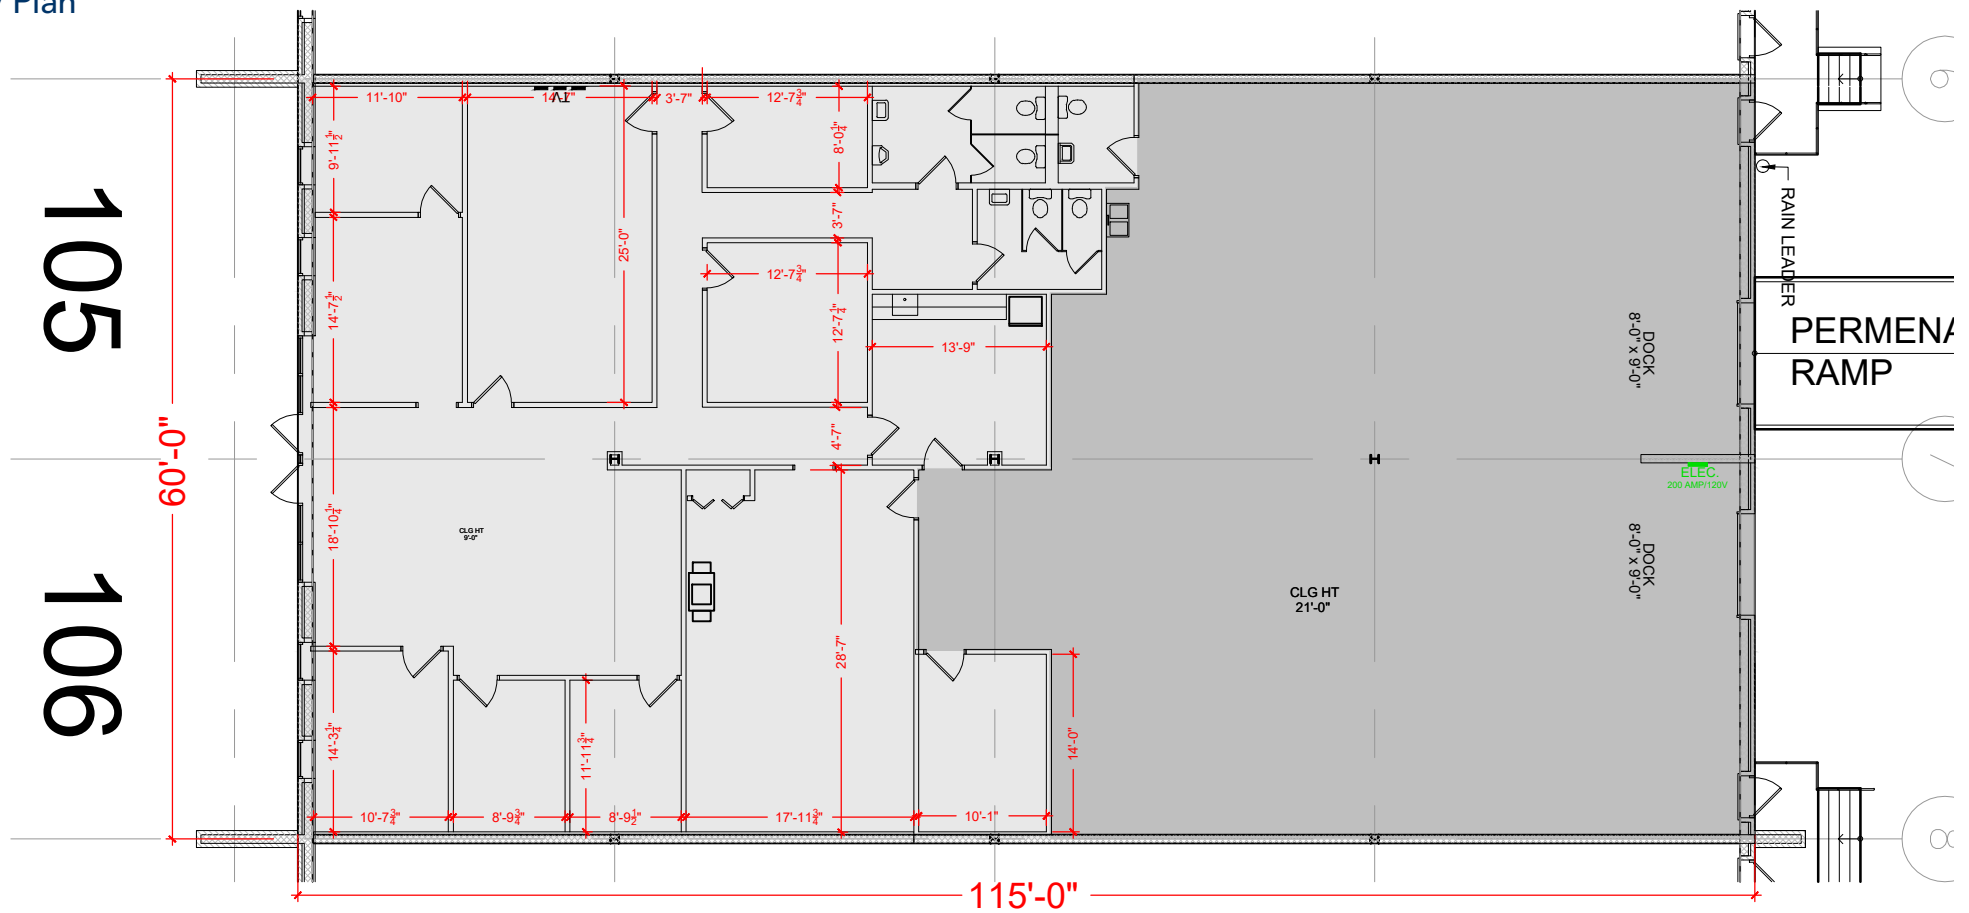

Floor Plan