



TOTAL SF AVAILABLE - 3,450 SF

OFFICE - 1,794 SF
WAREHOUSE SF - 1,656 SF

[Click to access 3D model](#)

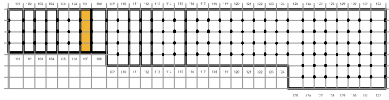

Key Plan

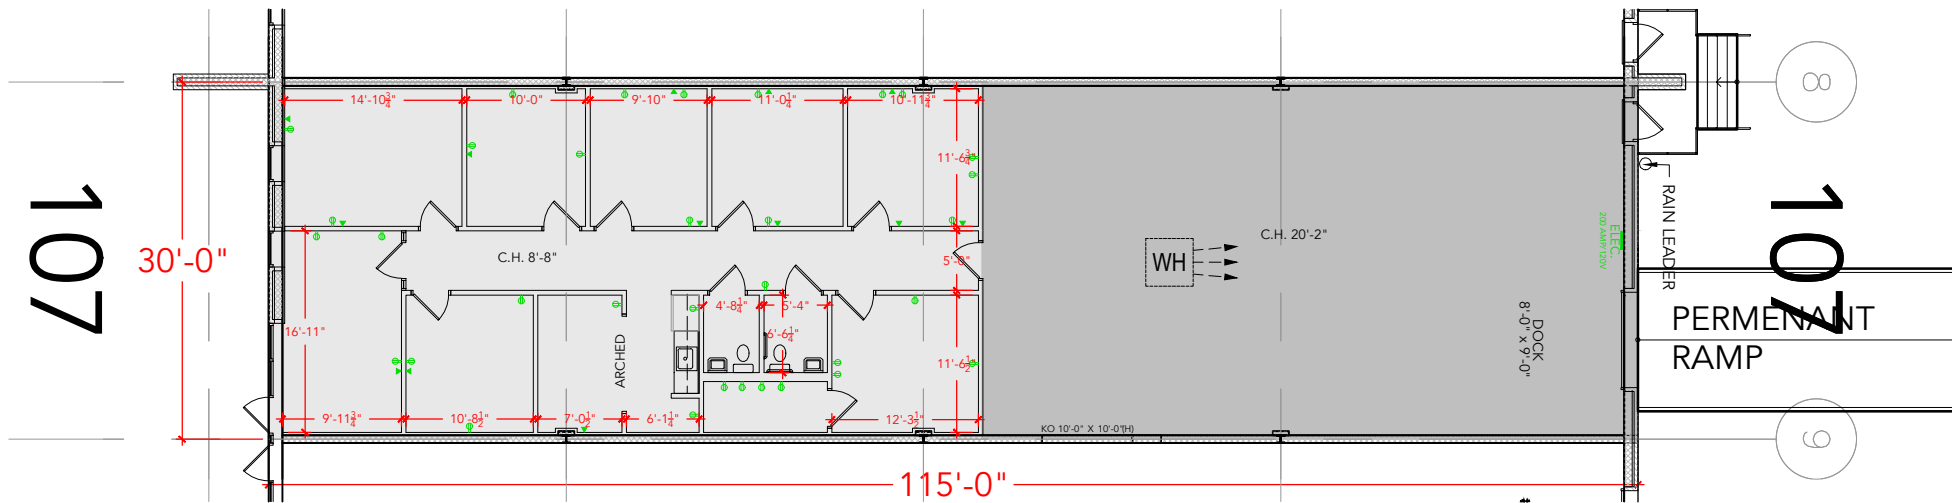

Floor Plan