




OFFICE - 2,324 SF
WAREHOUSE SF - 2,276 SF

Key Plan

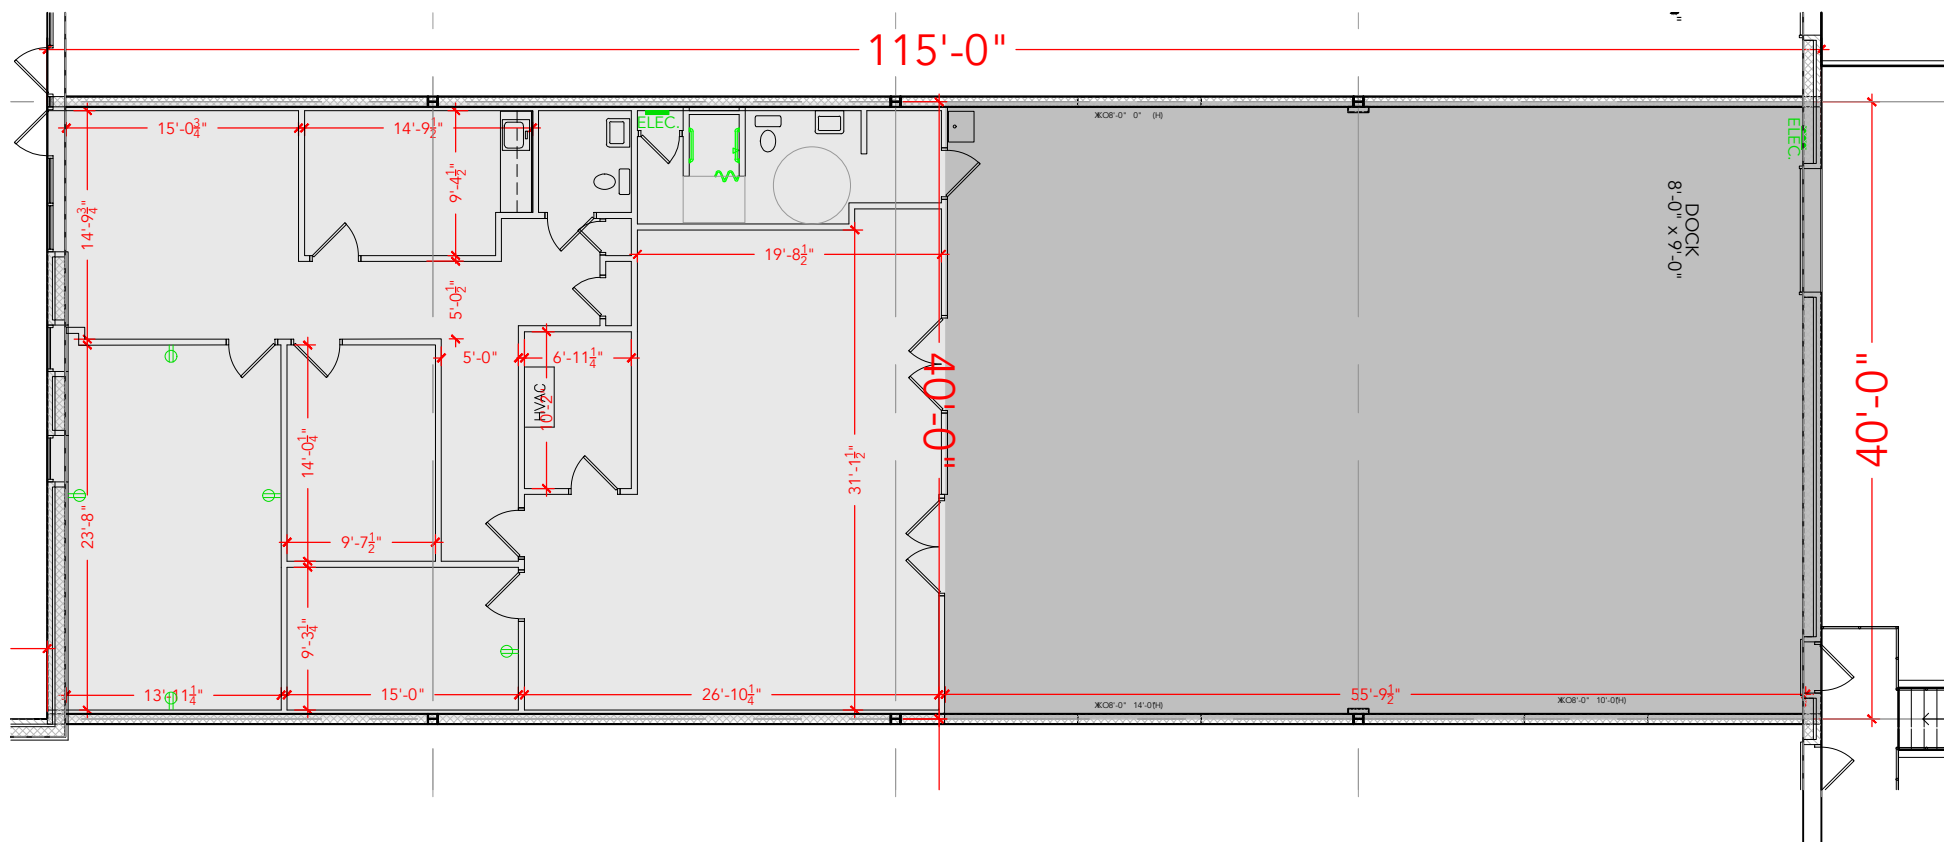

Floor Plan

DRAWING #: HR2-108 ASBUILT DATE: NEEDS TO BE