



TOTAL SF AVAILABLE -4,600 SF

OFFICE - 1,380 SF
WAREHOUSE - 3,220 SF

[Click to access CADD file](#)

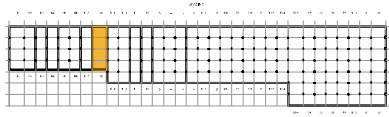

Key Plan

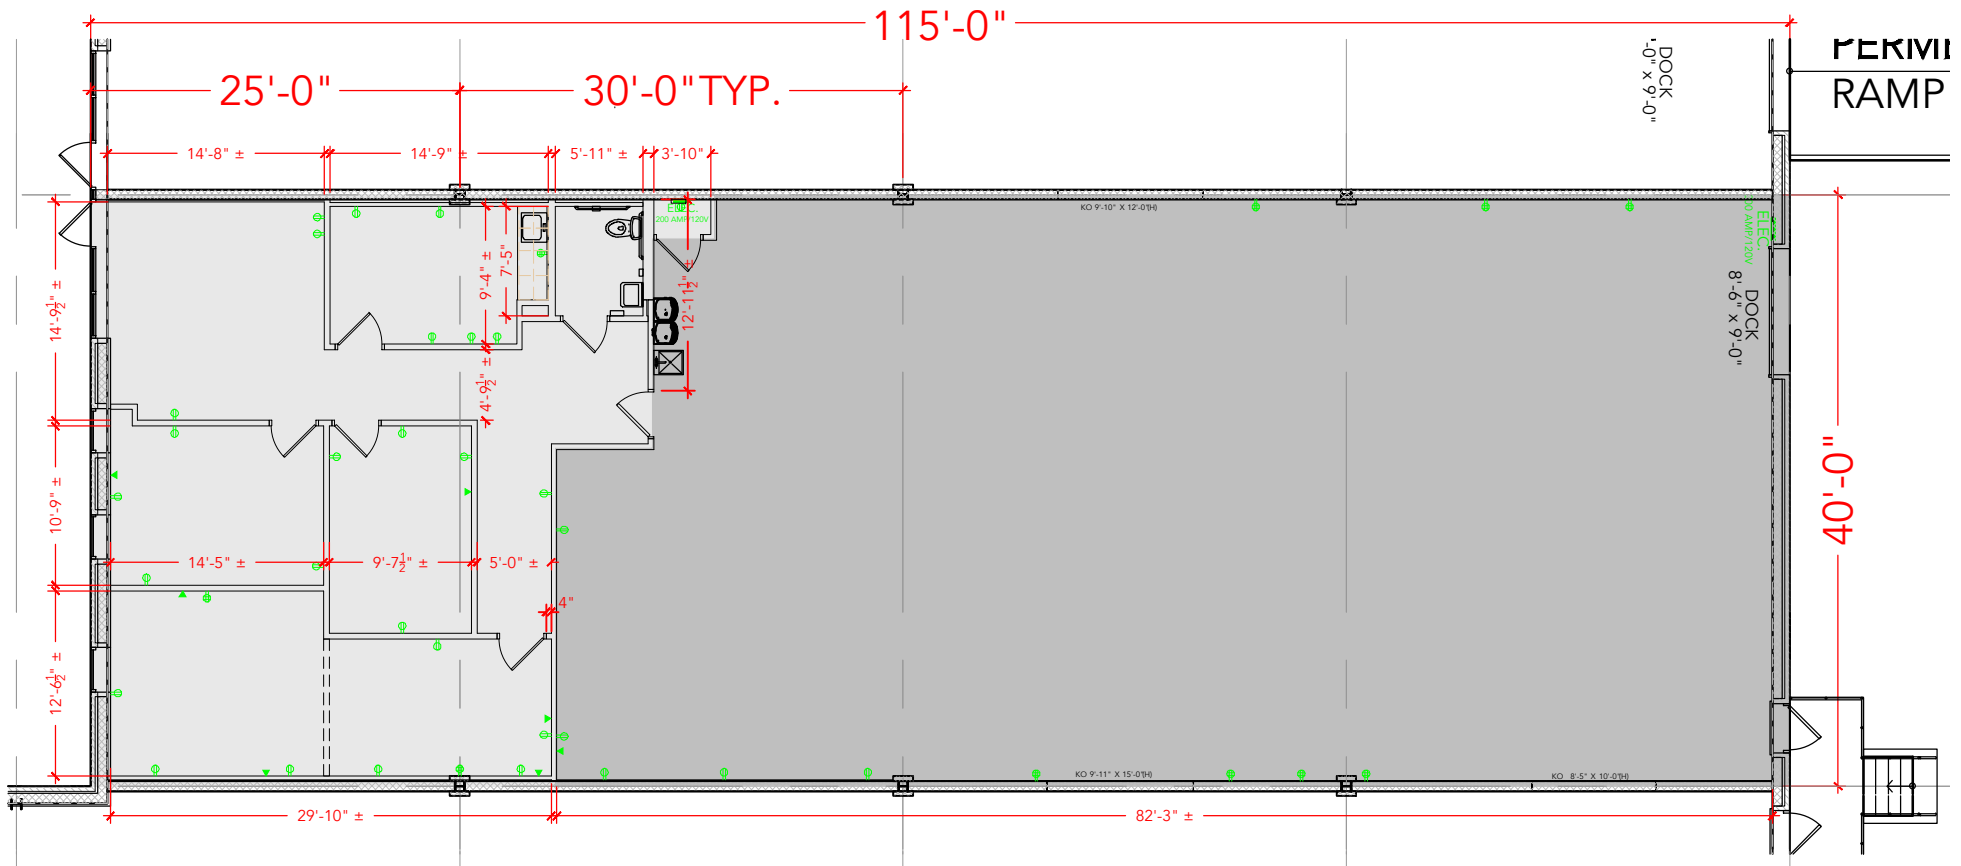

Floor Plan