



# Baltimore Commons

7484 Candlewood Road  
Suites R  
Hanover, MD 21076

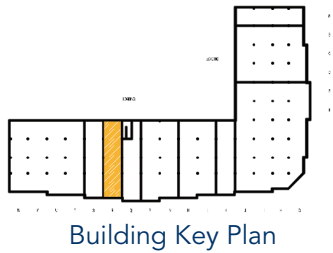

Total Office SF Available  
3,750 SF

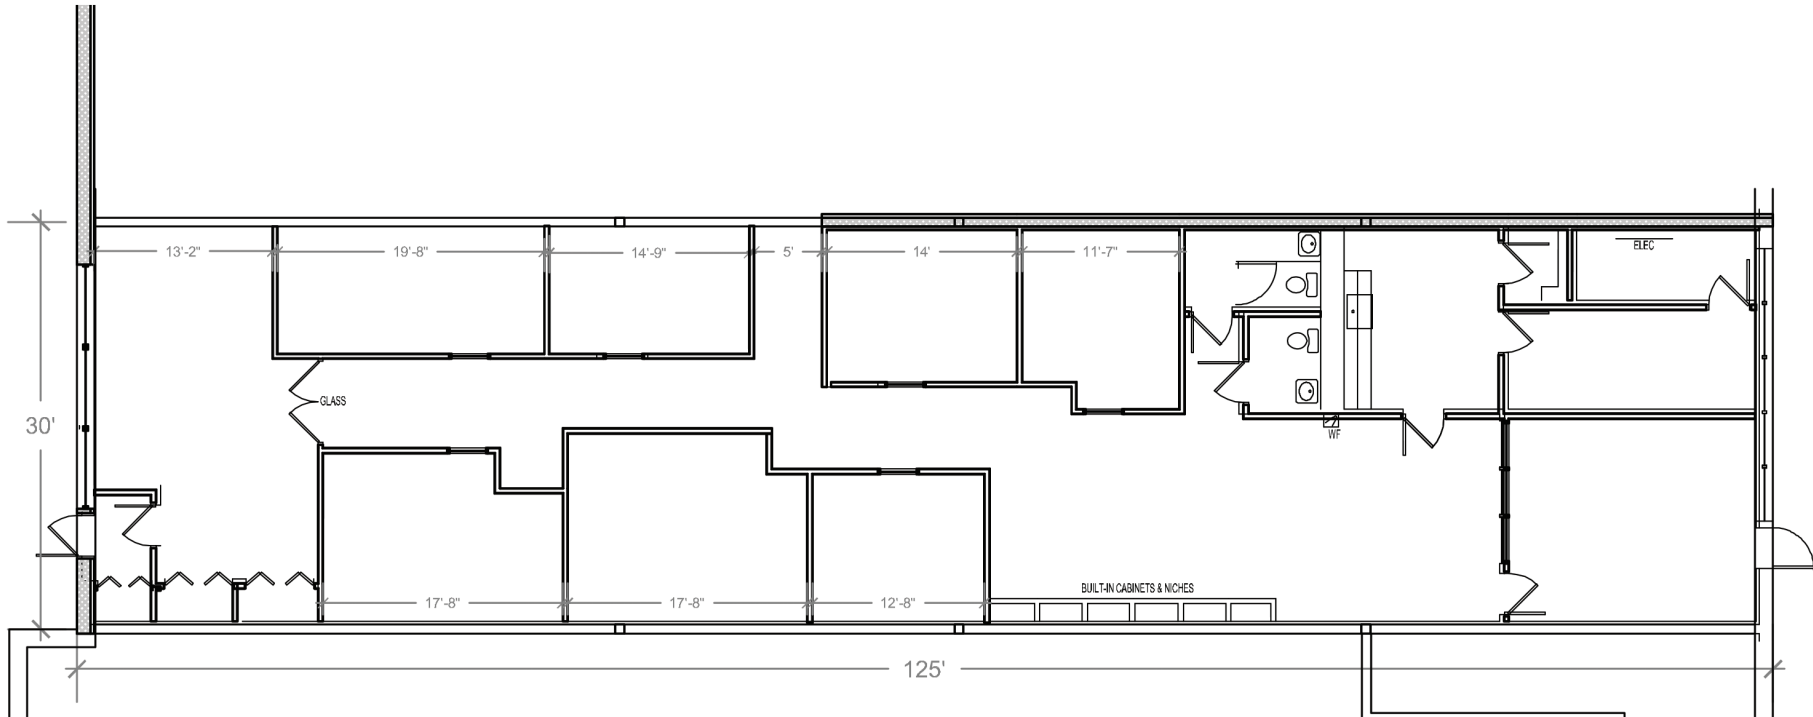

*Plan not to scale - this is not a construction document.*