


TOTAL SF AVAILABLE - 3,750 SF


OFFICE - 1,950 SF

WAREHOUSE - 1,800 SF

[Click to access 3D model](#)

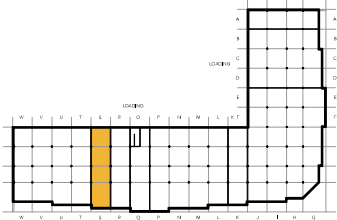

Key Plan

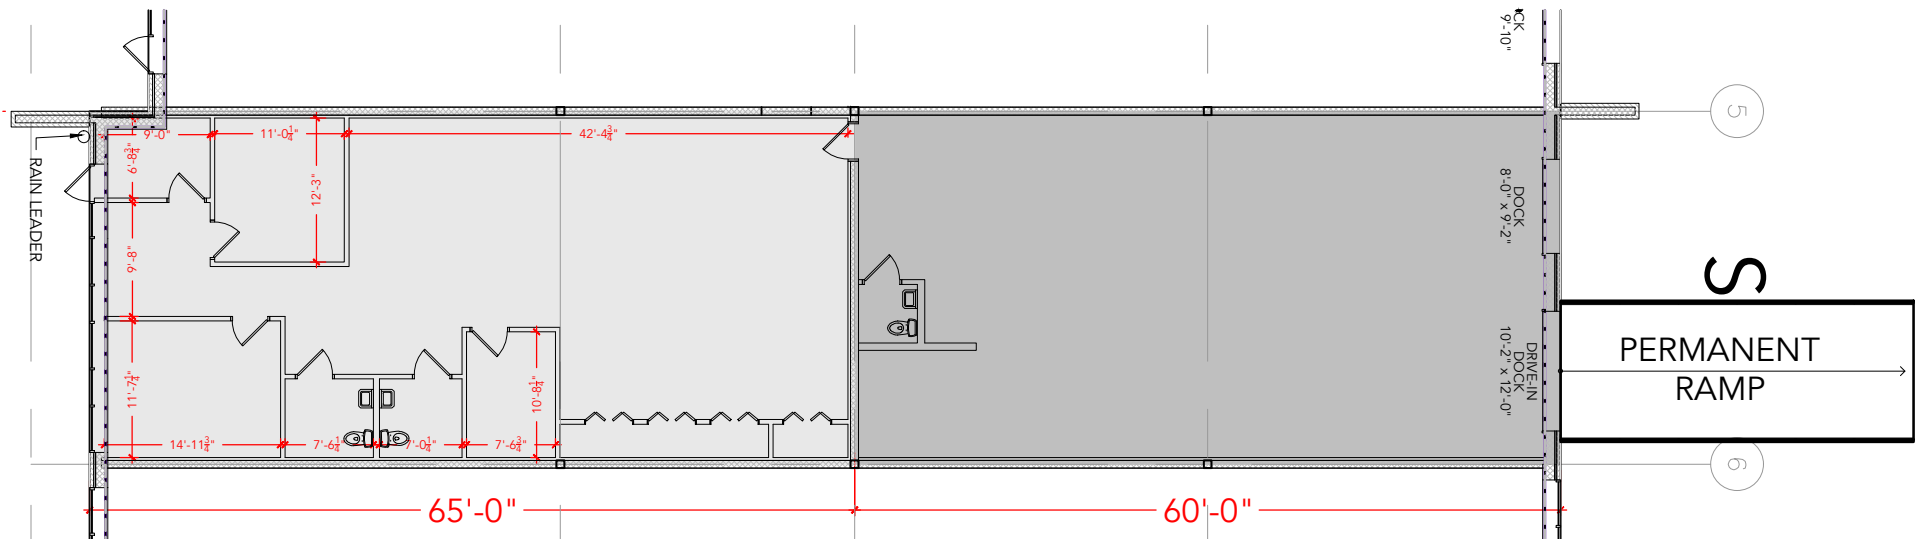

## Floor Plan