


**TOTAL SF AVAILABLE - 14,100 SF**


**OFFICE- 7,070 SF**

**WAREHOUSE - 7,030 SF**

[Click to access 3D model](#)

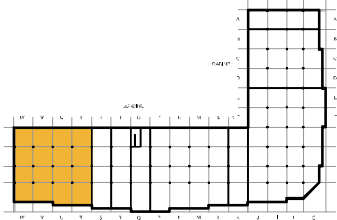

Key Plan

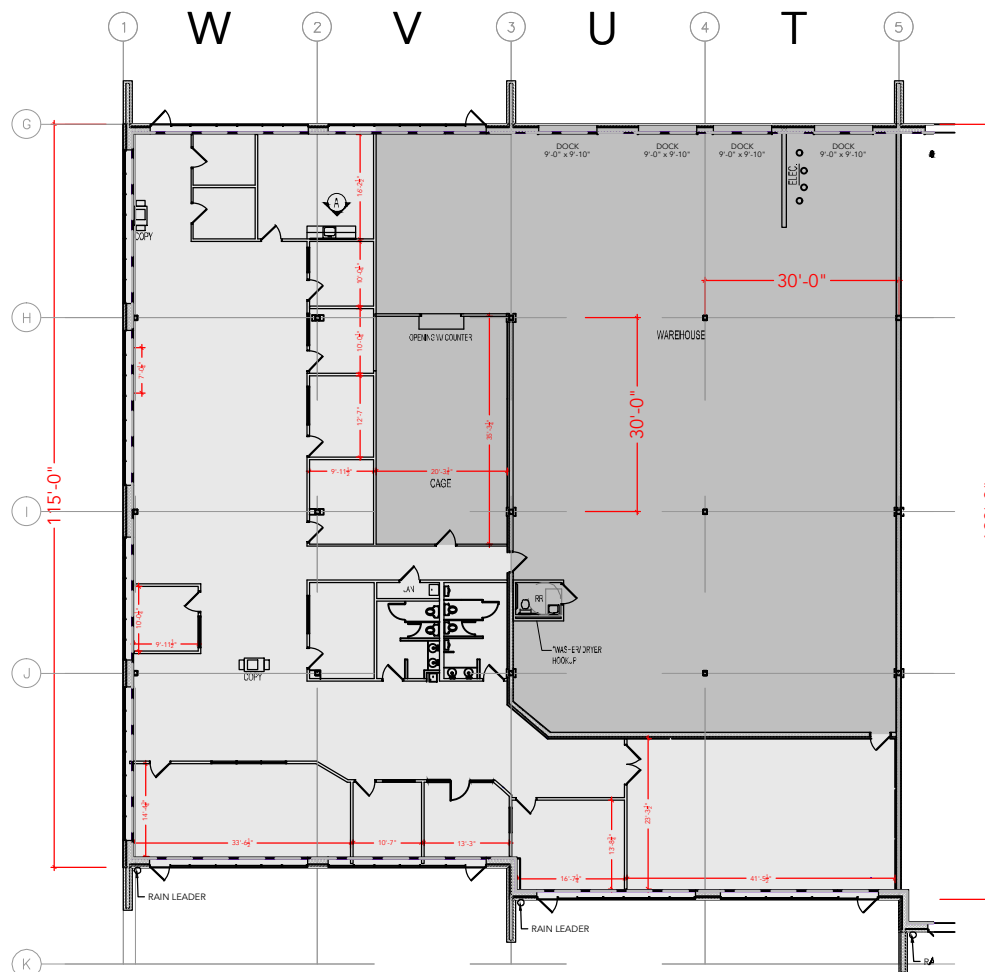

Floor Plan