


**TOTAL SF AVAILABLE - 57,944 RSF**

**OFFICE - 0,000 SF**


**WAREHOUSE - 0,000 RSF**

\* INCLUDES % OF METER ROOM

[Click to access 3D model](#)

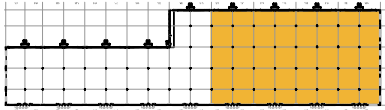

Key Plan

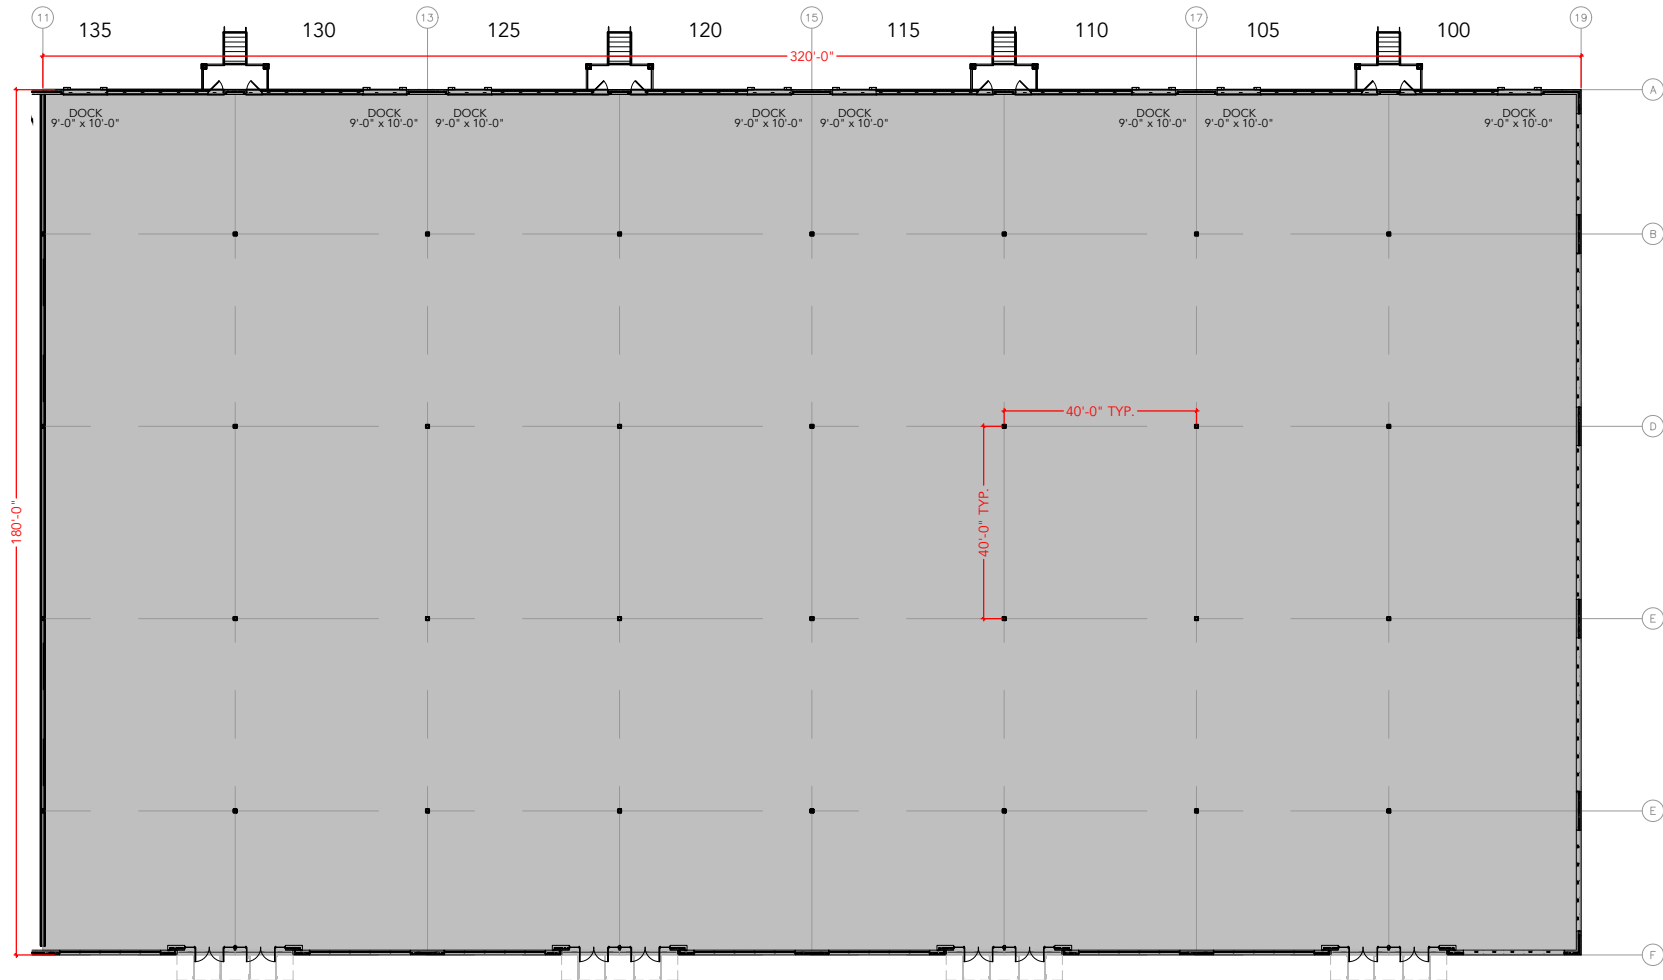

Floor Plan