



**TOTAL SF AVAILABLE - 8,852 RSF**

**OFFICE - 666 RSF**

**WAREHOUSE - 8,186 RSF**

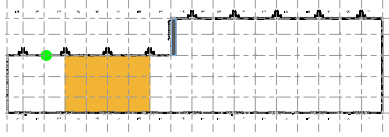

Key Plan

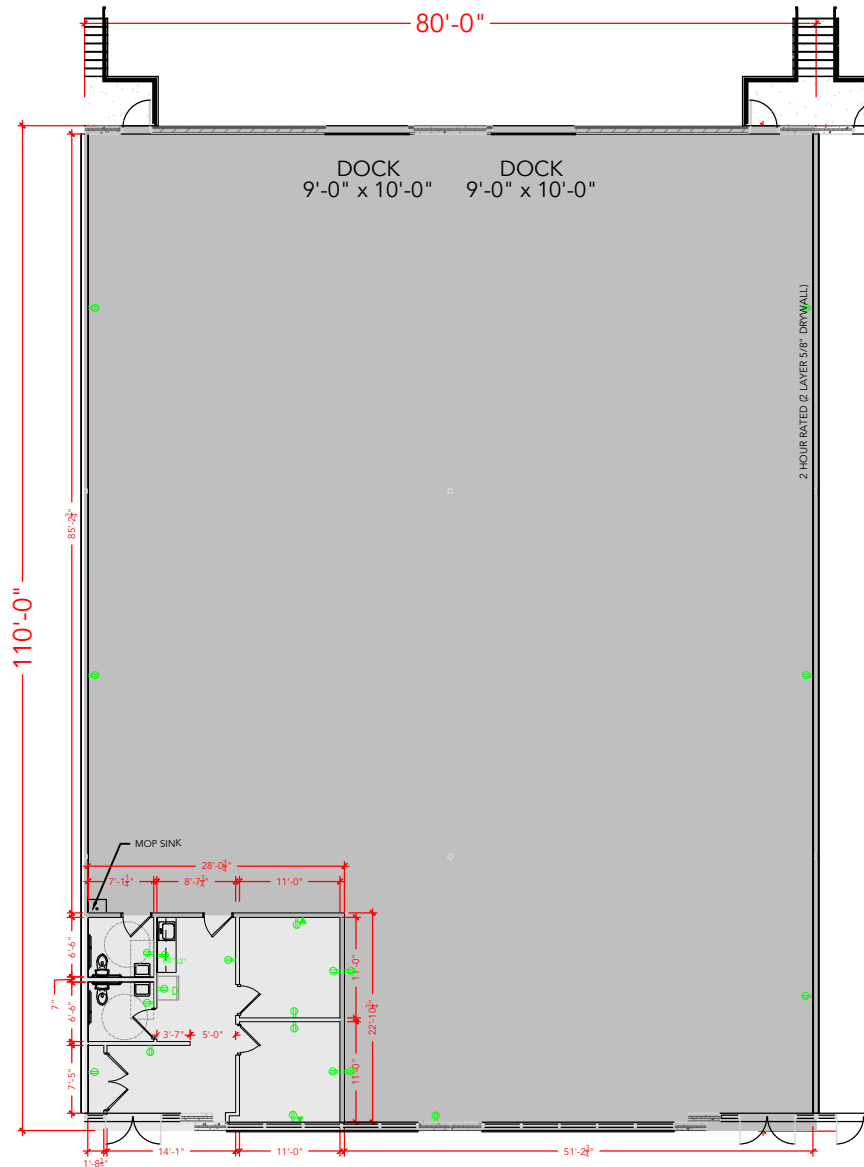

Floor Plan