

TOTAL SF AVAILABLE - 91,170 RSF

OFFICE - 0,000 SF


WAREHOUSE - 91,170 RSF

\* INCLUDES % OF METER ROOM

[Click to access 3D model](#)



## Key Plan

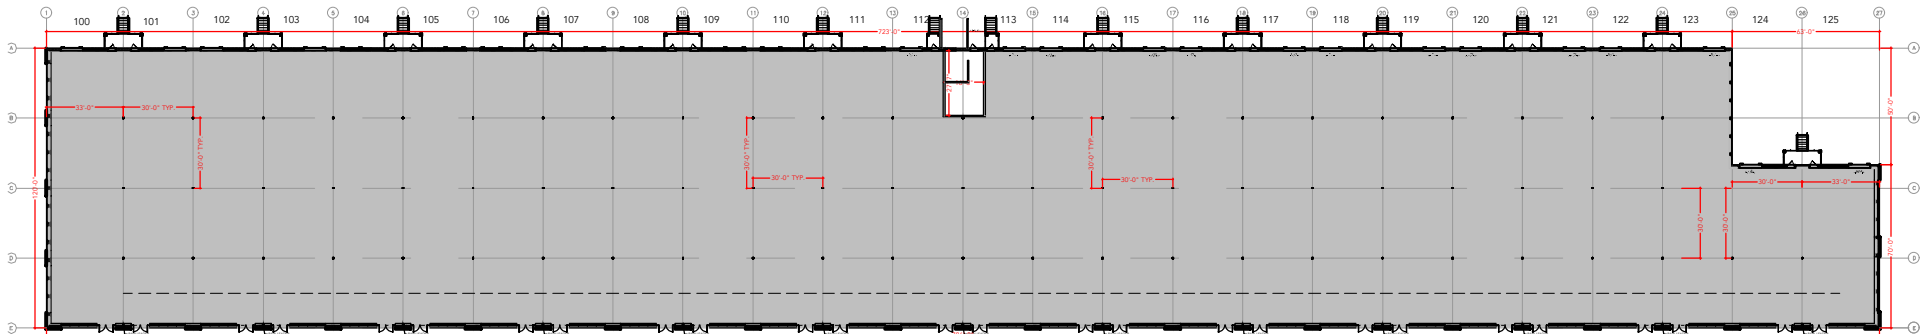

## Floor Plan