


TOTAL SF AVAILABLE - 5,424 RSF

OFFICE - 0,000 RSF


WAREHOUSE - 5,424 RSF

\* INCLUDES % OF METER ROOM

[Click to access 3D model](#)

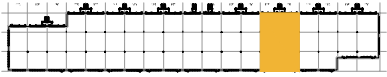

Key Plan

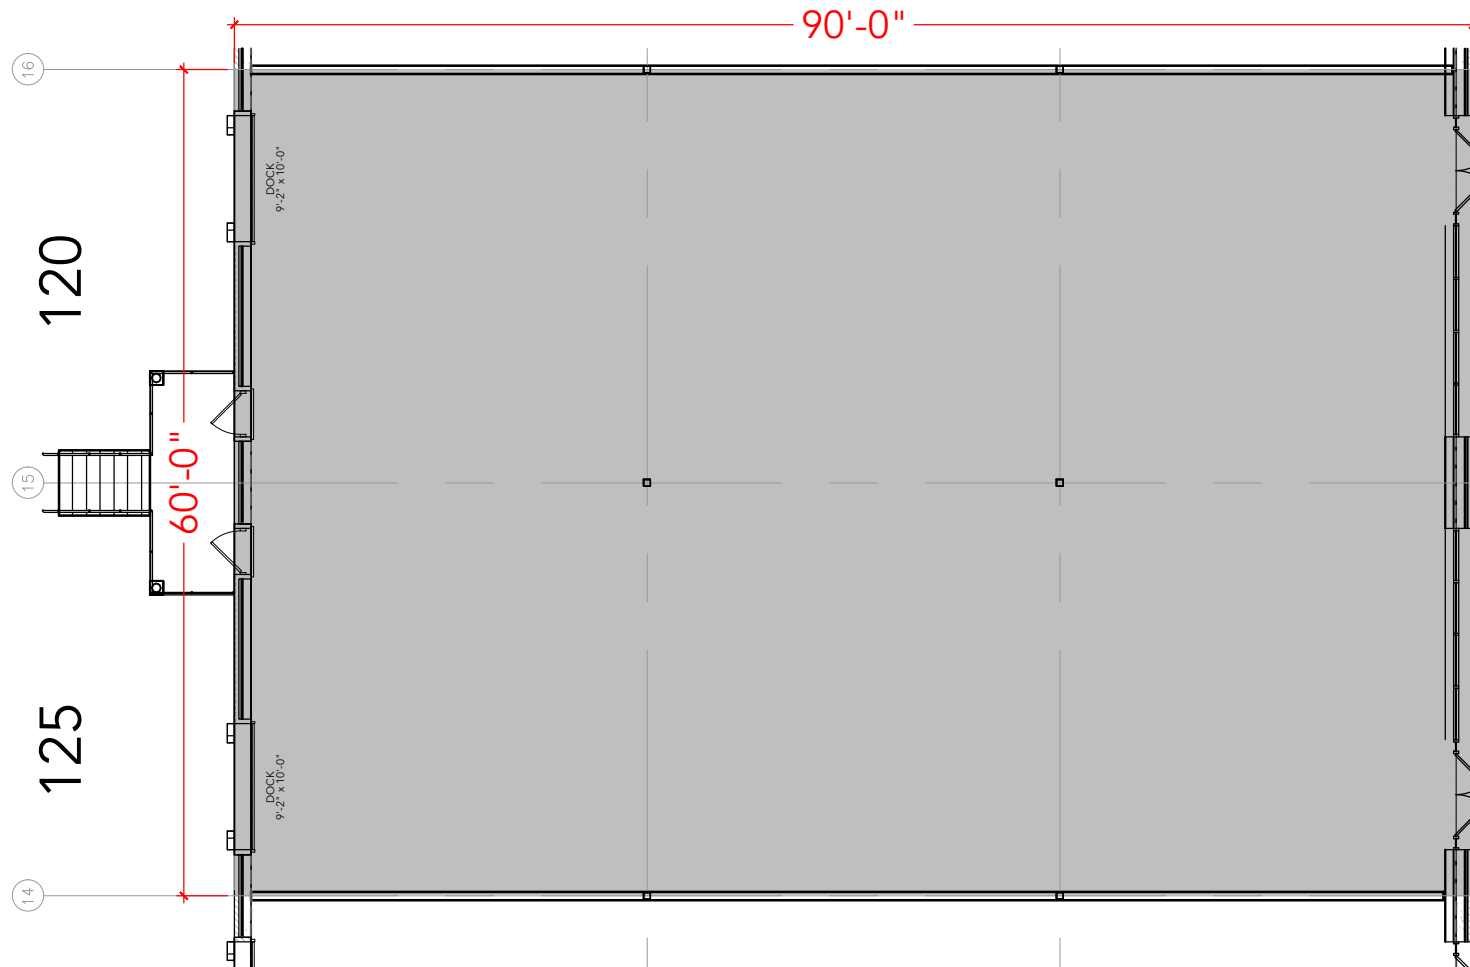

Floor Plan