

TOTAL SF AVAILABLE - 10,848 RSF

OFFICE - 0,000 SF


WAREHOUSE - 10,848 RSF

* INCLUDES % OF METER ROOM

[Click to access 3D model](#)



Key Plan

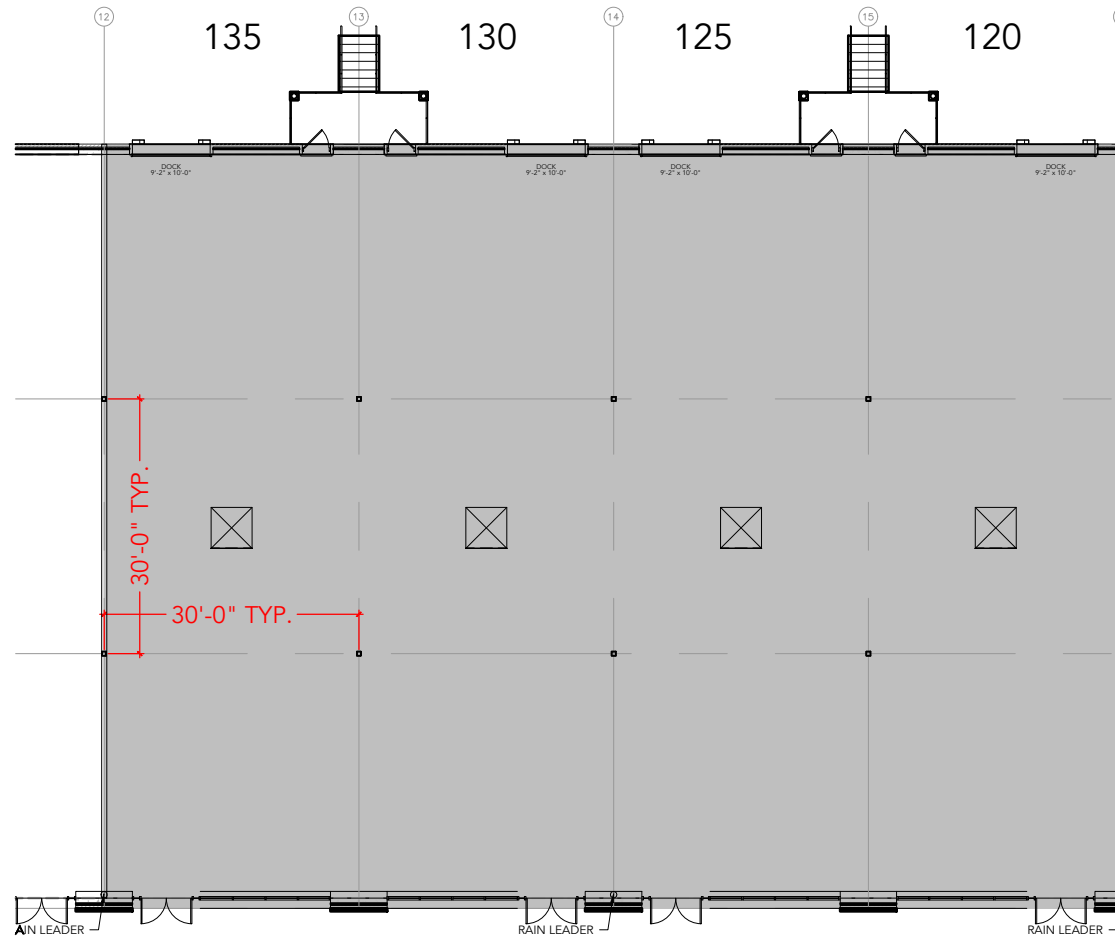

Floor Plan