


TOTAL SF AVAILABLE - 38,633 SF

OFFICE - 0,000 SF


WAREHOUSE - 38,633 SF

* INCLUDES % OF METER ROOM

[Click to access 3D model](#)

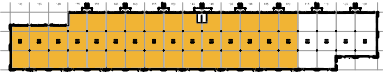

Key Plan

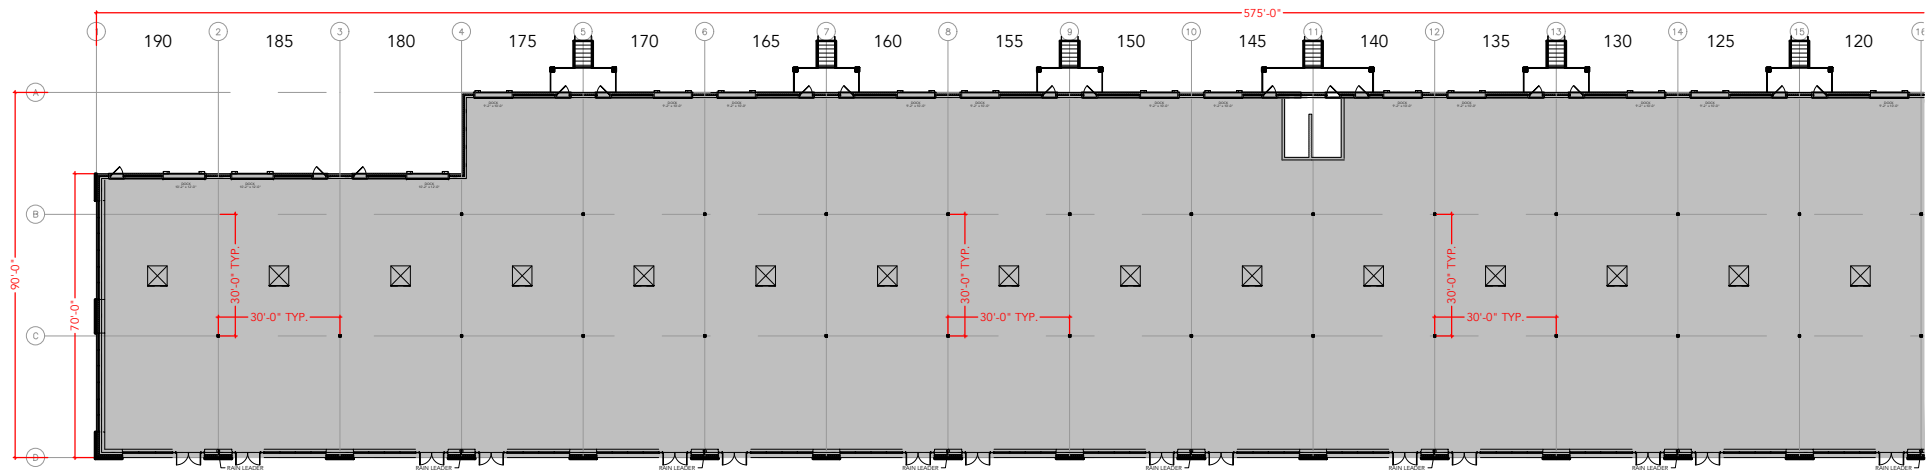

Floor Plan