


TOTAL SF AVAILABLE -8,115 RSF(12%)



[Click to access CADD file](#)

Key Plan

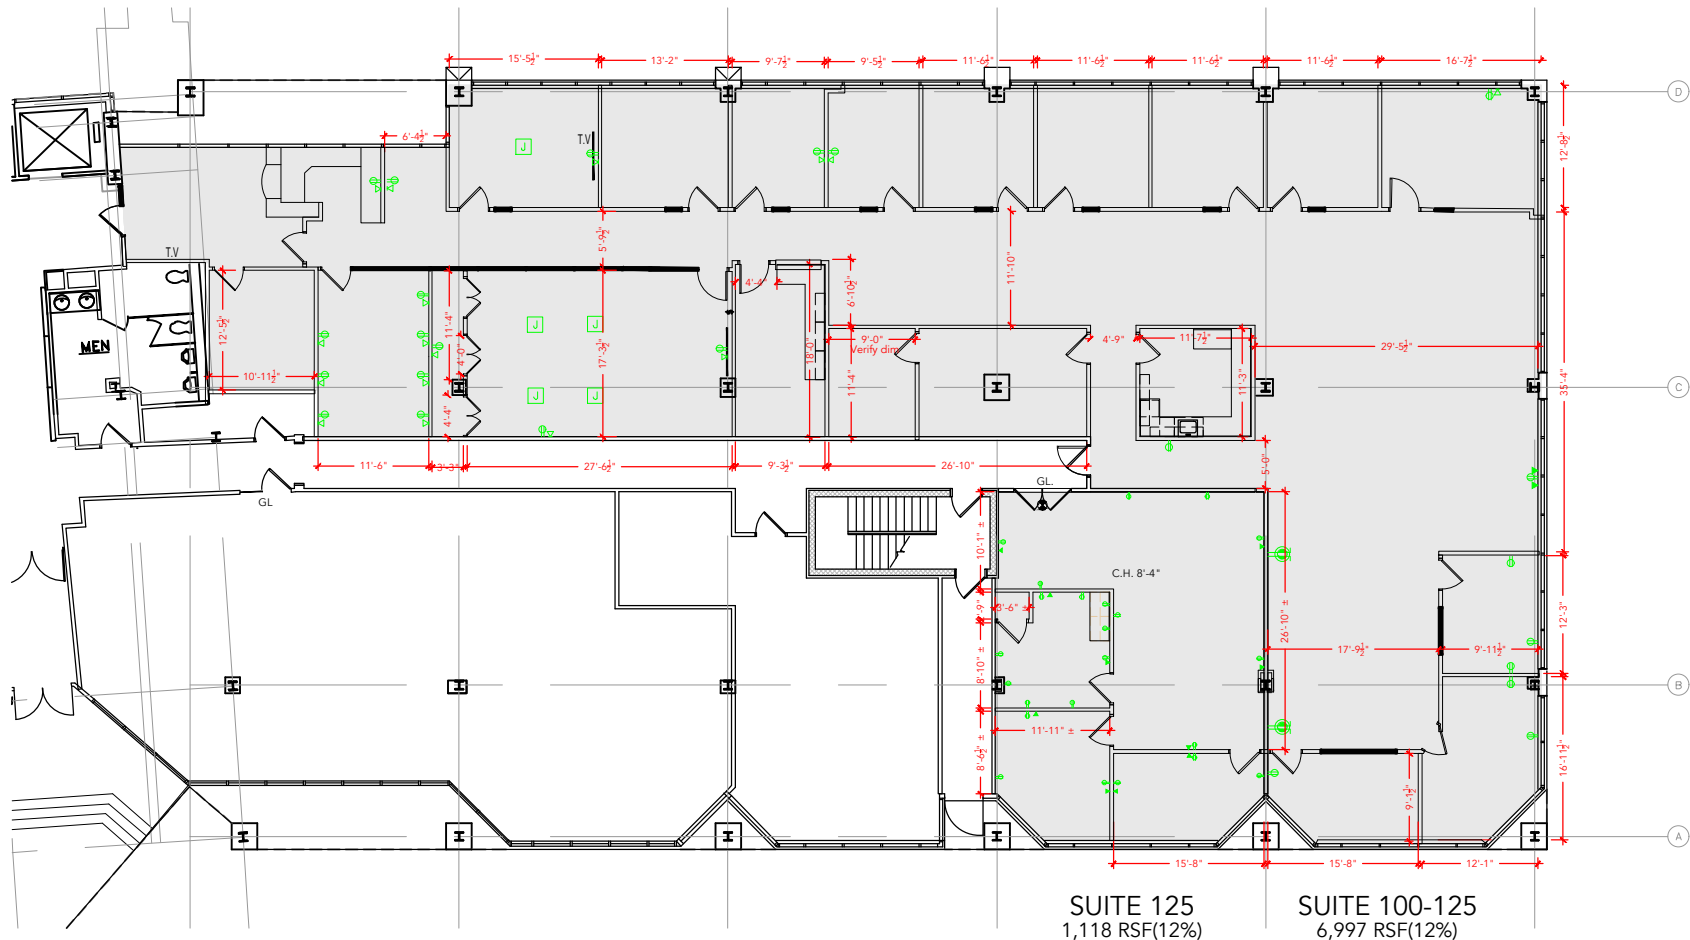

Floor Plan