


TOTAL SF AVAILABLE - 2,184 RSF(12%)

[Click to access CADD file](#)



Key Plan

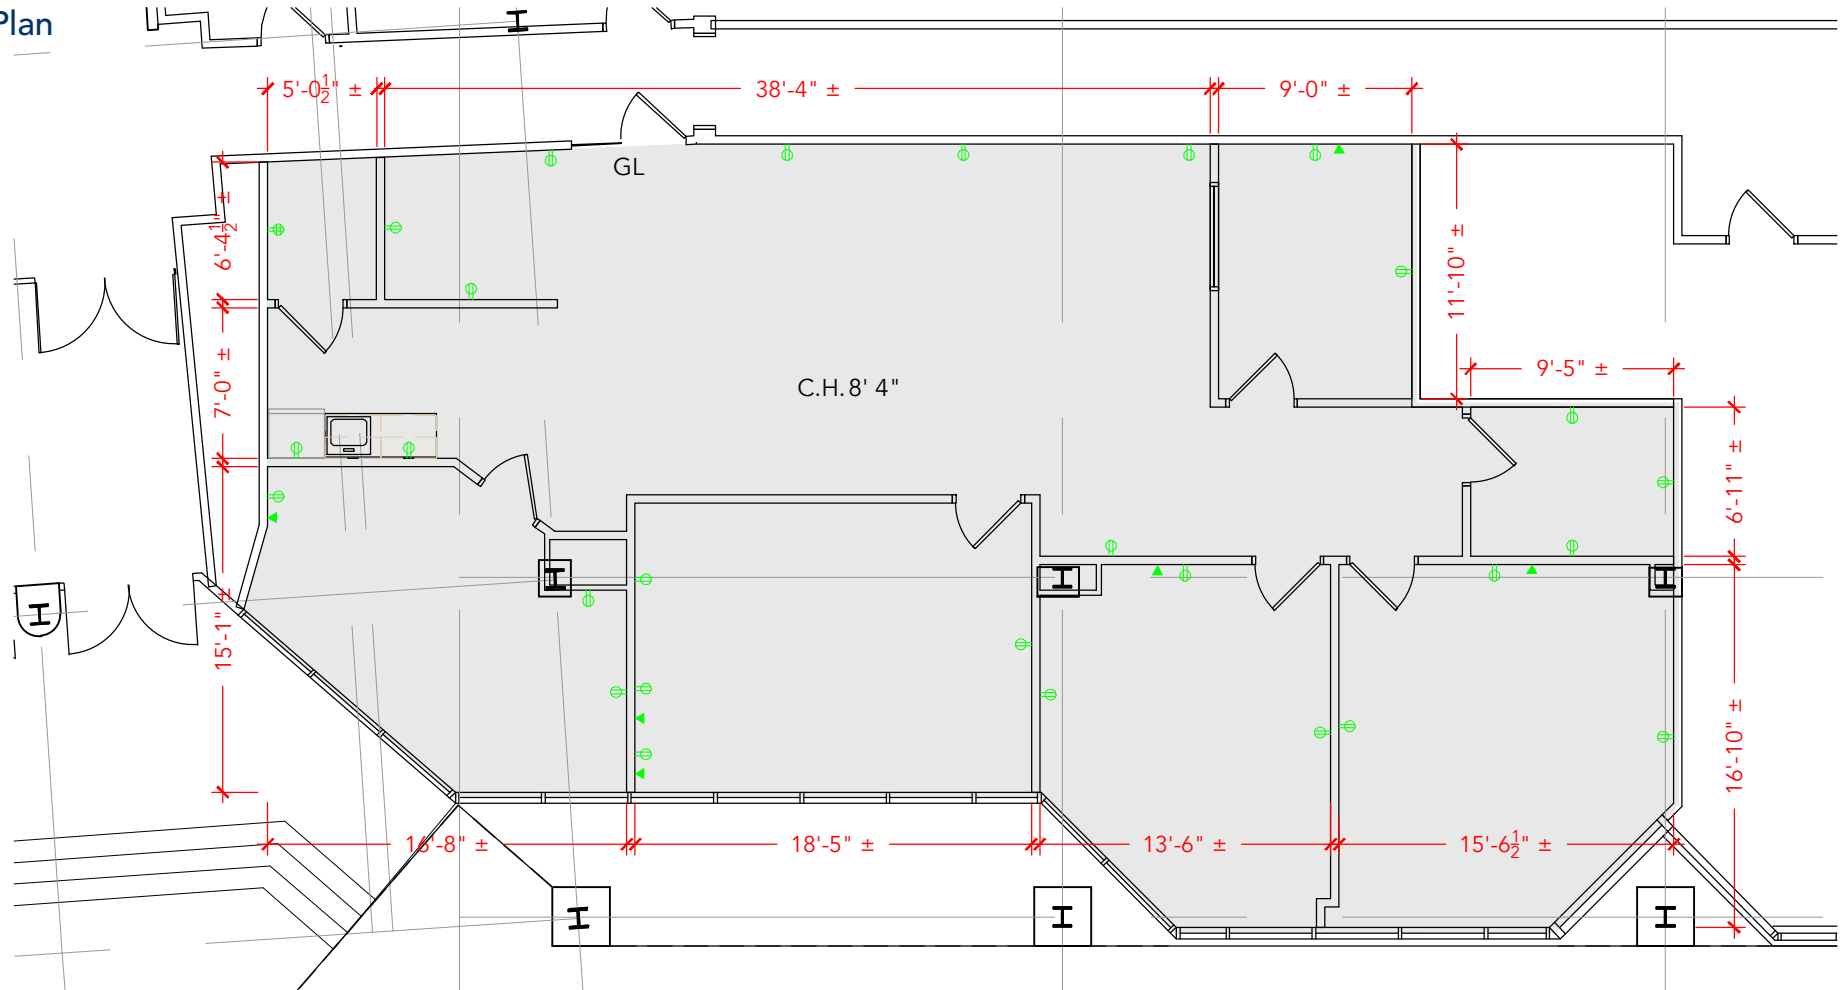

Floor Plan