



TOTAL SF AVAILABLE -1,758 RSF (12%)

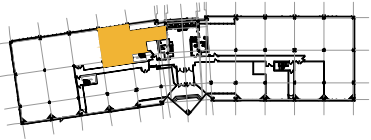

[Click to access CADD file](#)

Key Plan

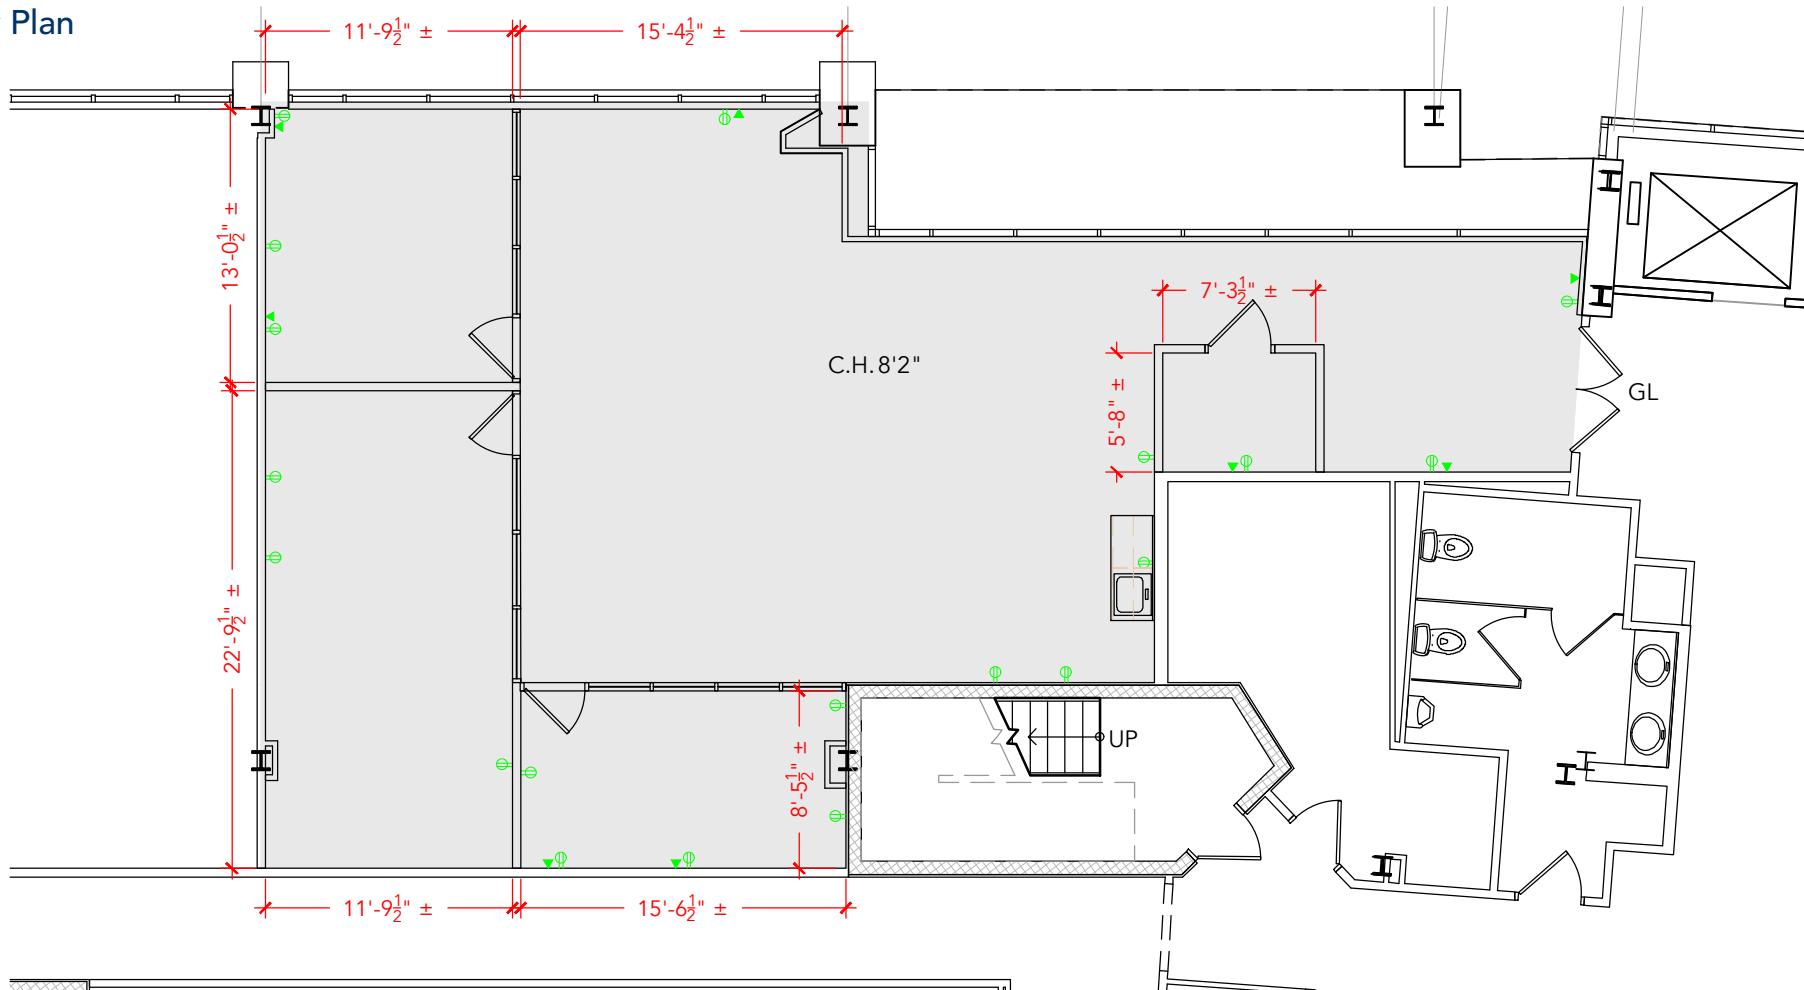

Floor Plan