


TOTAL SF AVAILABLE - 5,227 RSF (12%)



[Click to access CADD file](#)

## Key Plan

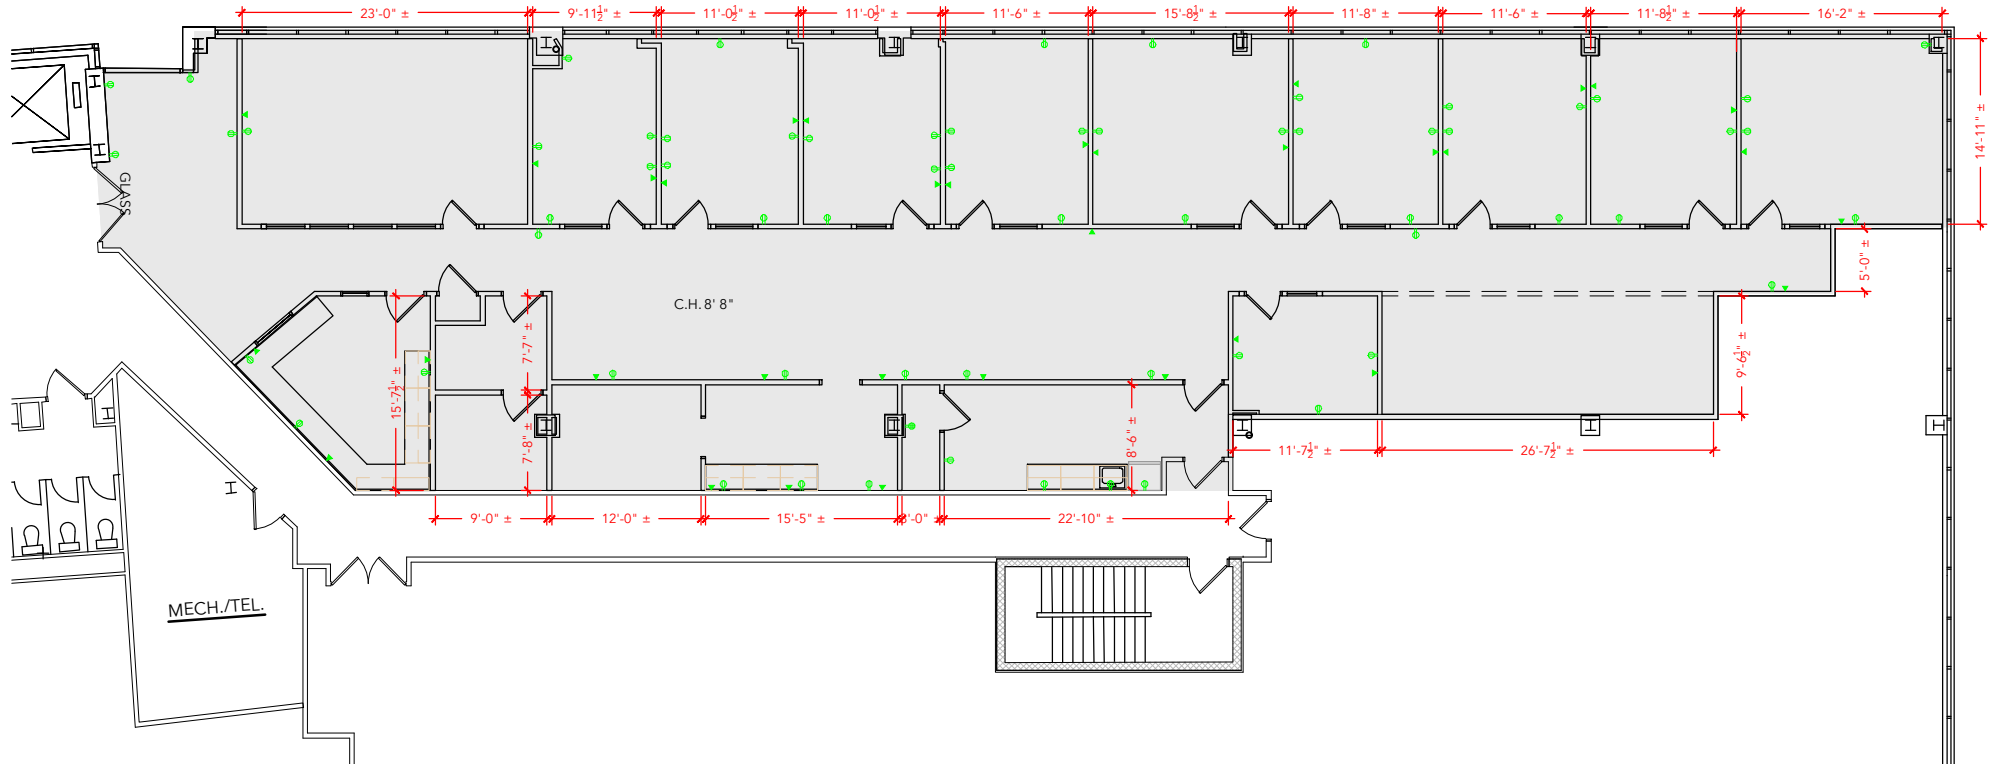

## Floor Plan