


TOTAL SF AVAILABLE - 10,393 RSF (12%)

[Click to access 3D model](#)



## Key Plan

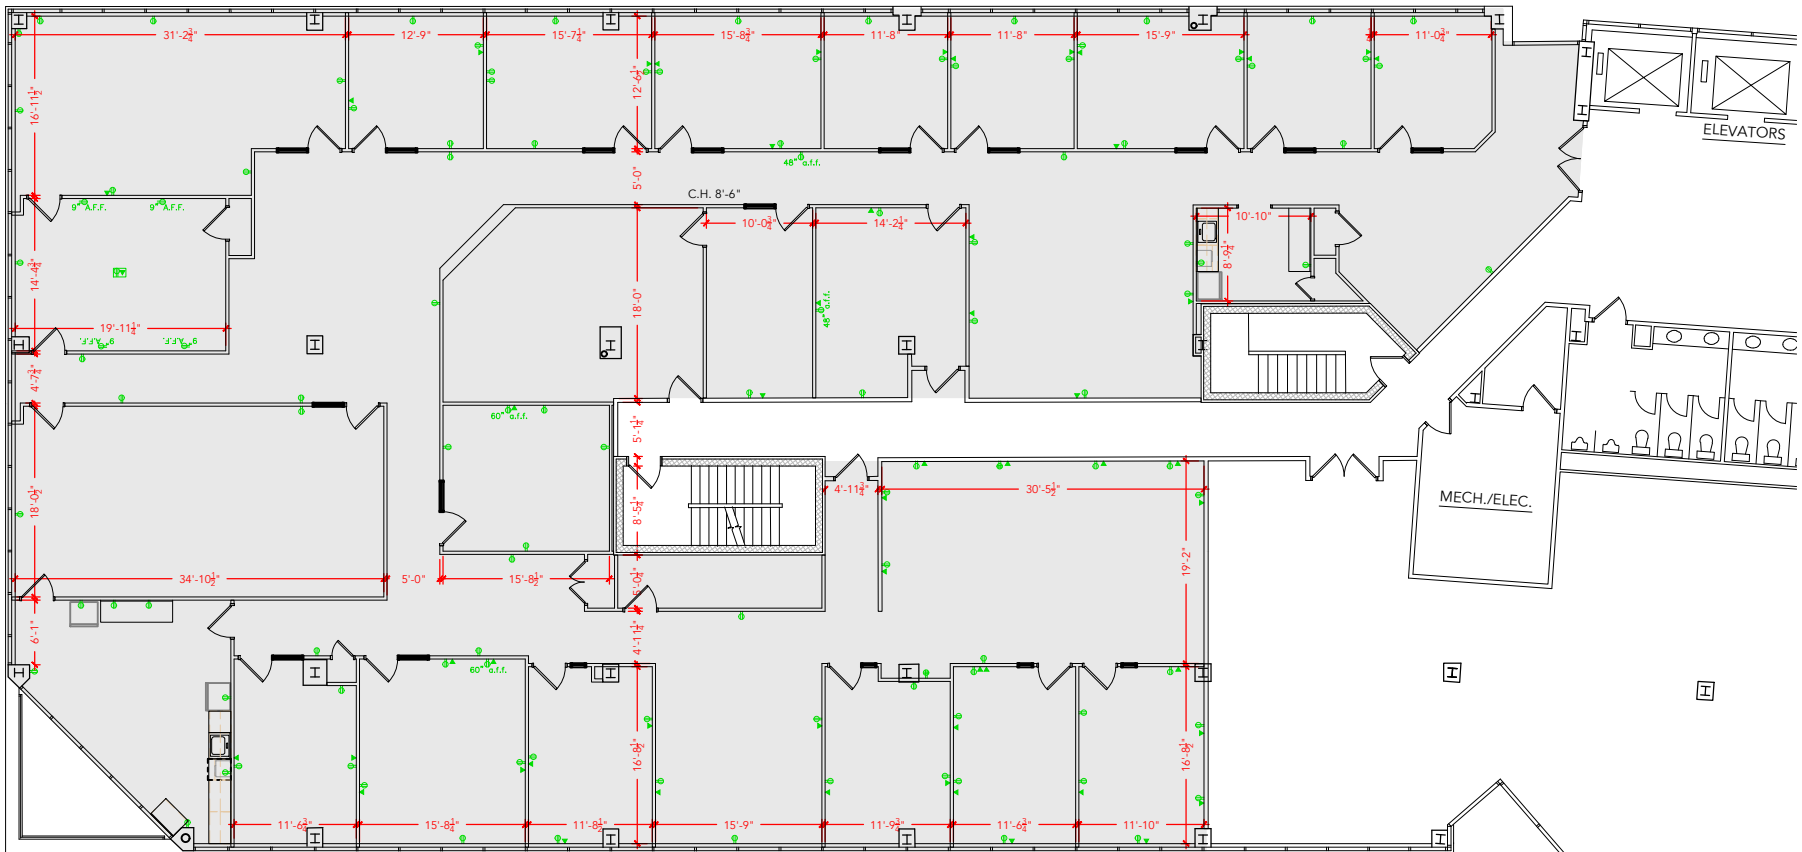

NOTE:  
ALL INTERIOR WALL 3-5/8" U.N.O.  
8'-0" DOOR HEIGHT

## Floor Plan