



TOTAL SF AVAILABLE - 3,619 RSF (12%)

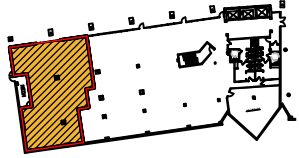

[Click to access 3D model](#)

## Key Plan

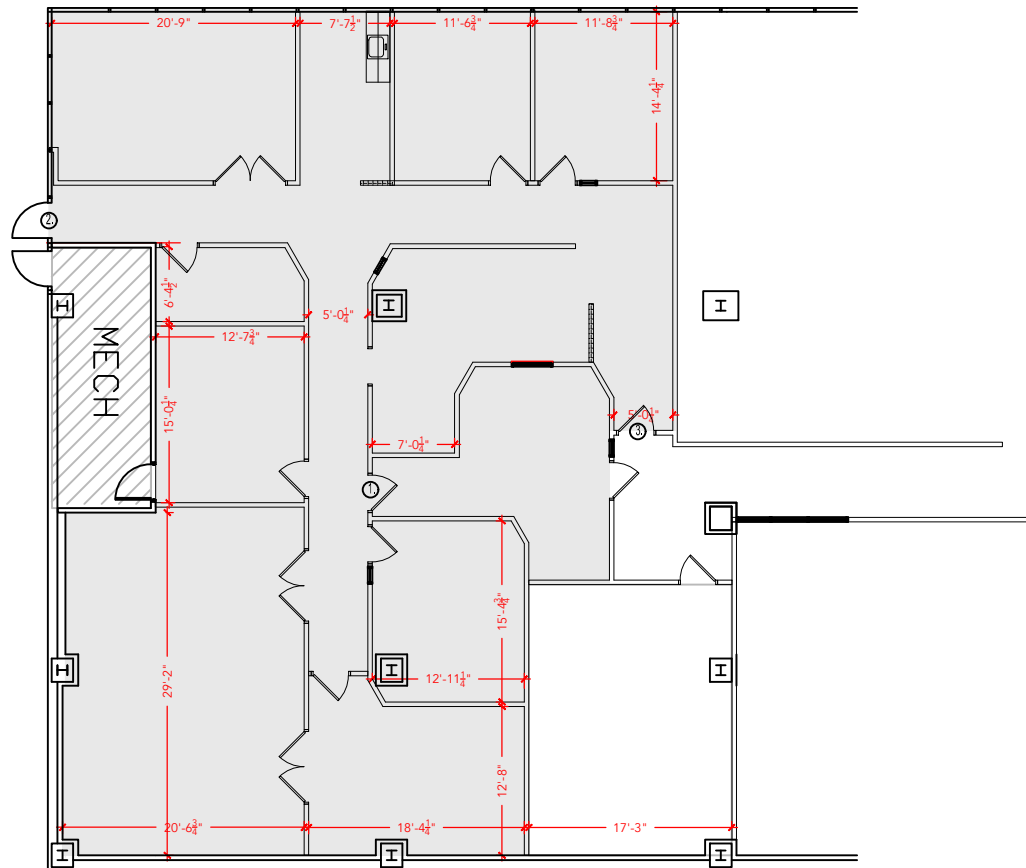

TERRACE LEVEL

## Floor Plan