
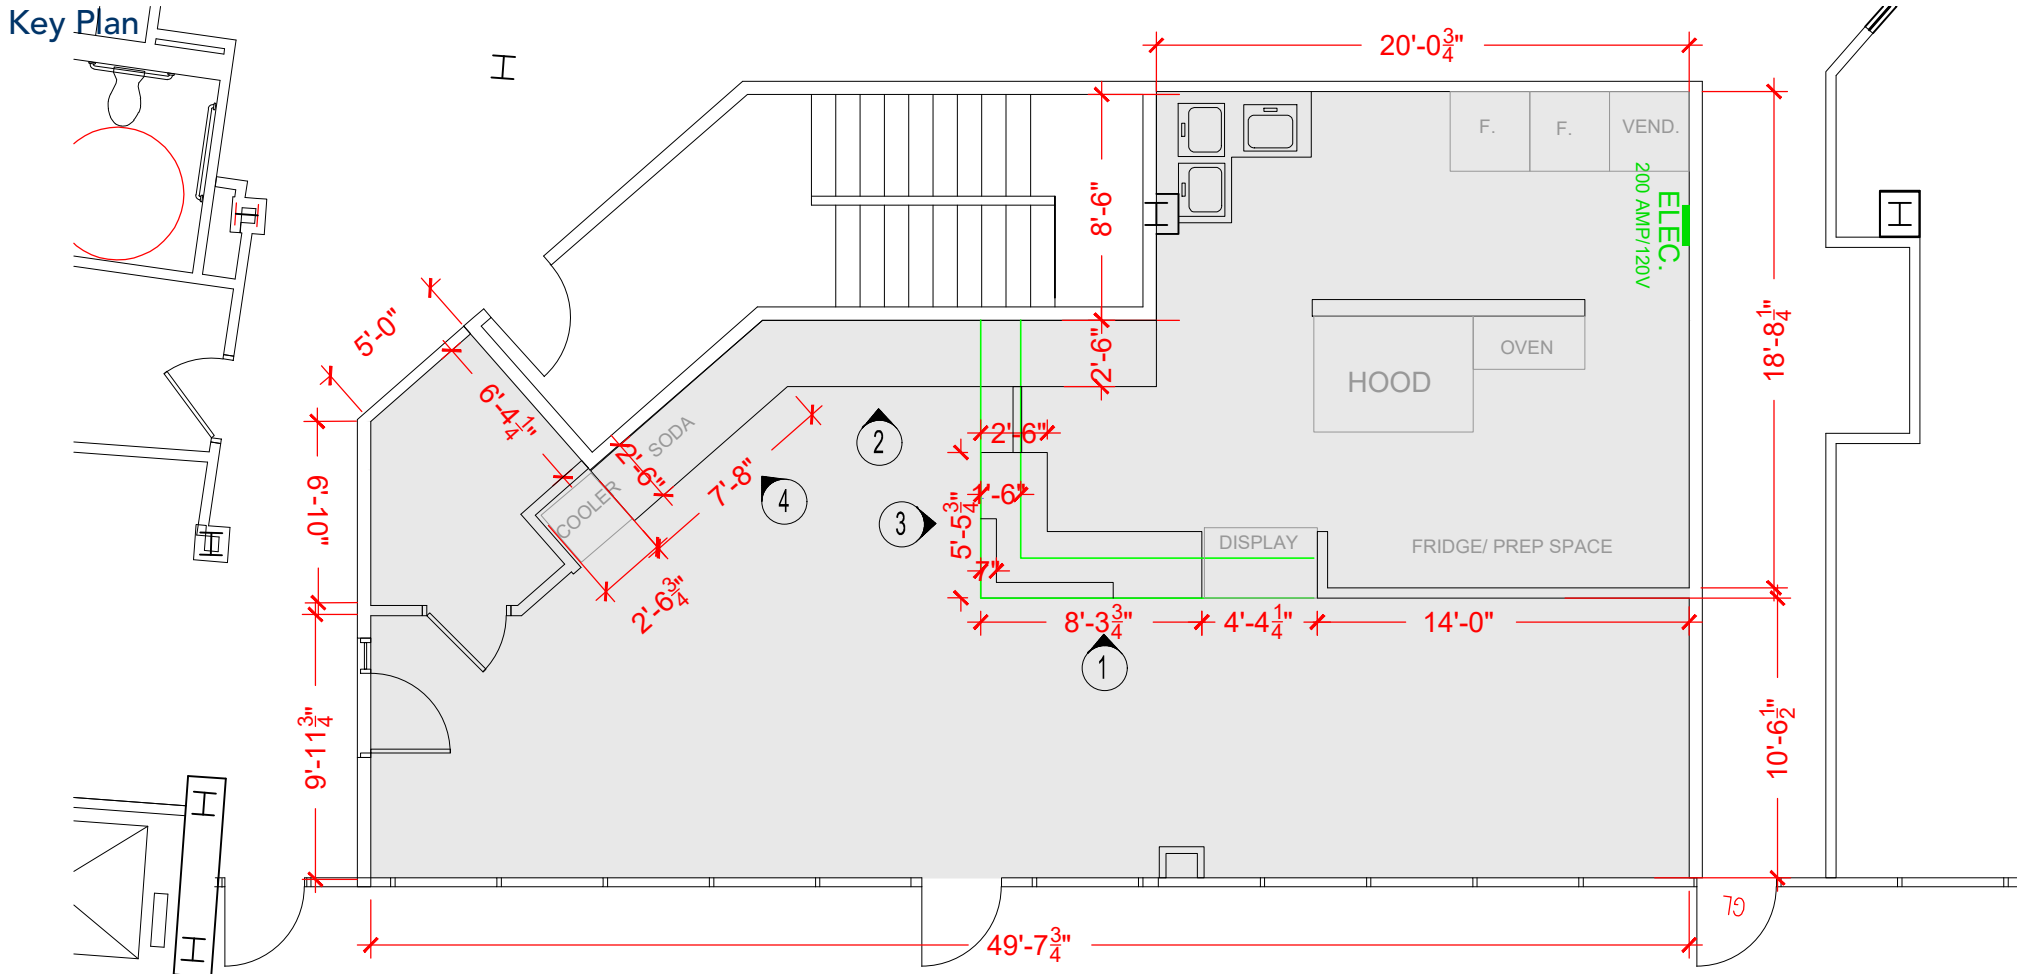


TOTAL SF AVAILABLE - 1,316 RSF (12%)

[Click to access 3D model](#)

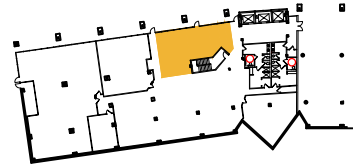

Floor Plan