


TOTAL SF AVAILABLE -11,234 RSF

OFFICE - 1,539 RSF


WAREHOUSE - 9,695 RSF

* INCLUDES % OF METER ROOM

[Click to access CADD file](#)

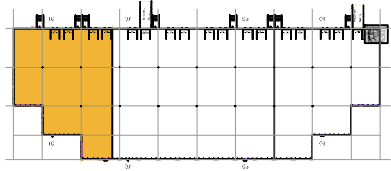

Key Plan

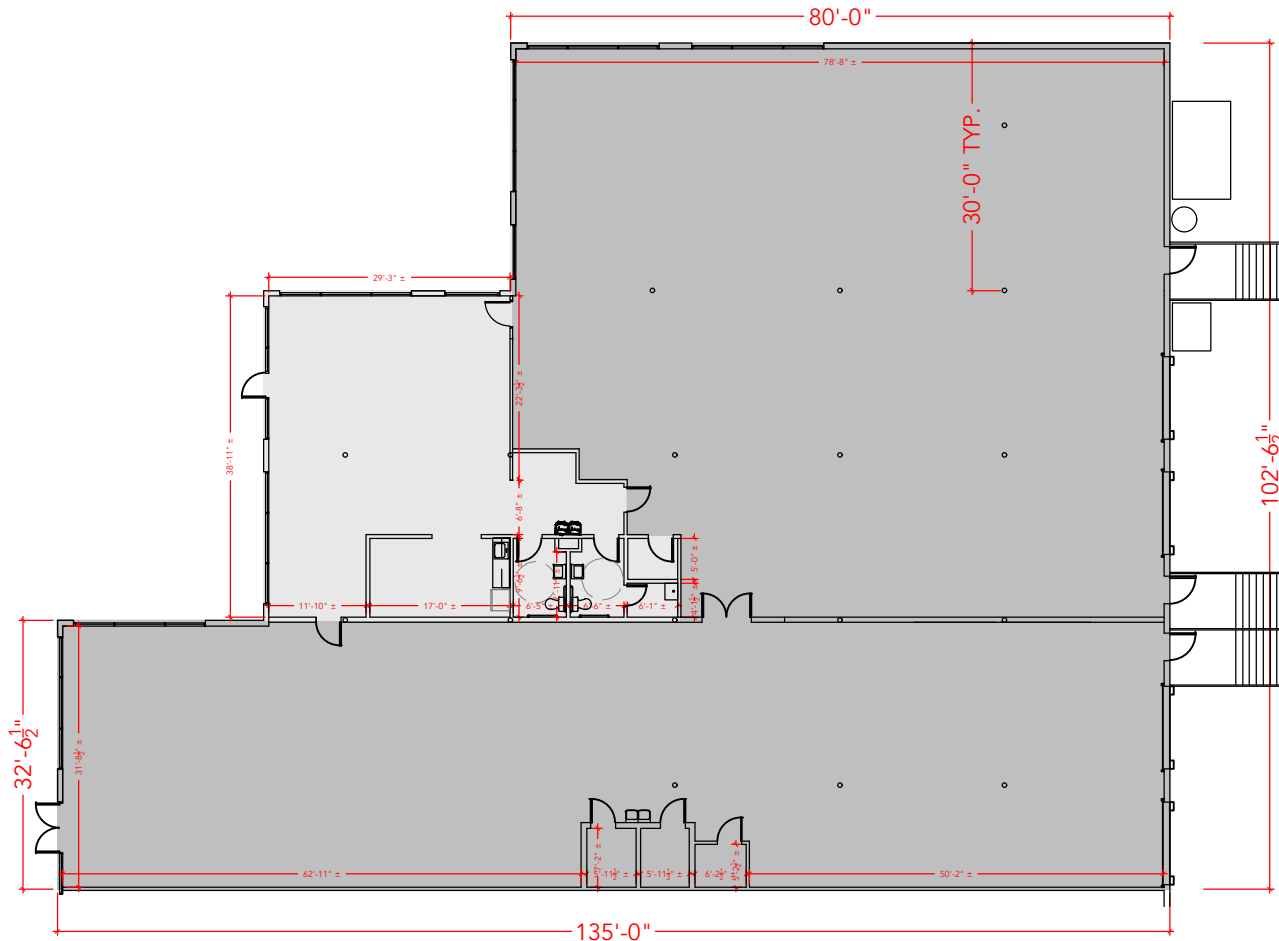

Floor Plan