

**TOTAL SF AVAILABLE -15,000 SF**


**OFFICE - 6,360 SF**

**WAREHOUSE - 8,640 SF**

[Click to access CADD file](#)



**Key Plan**

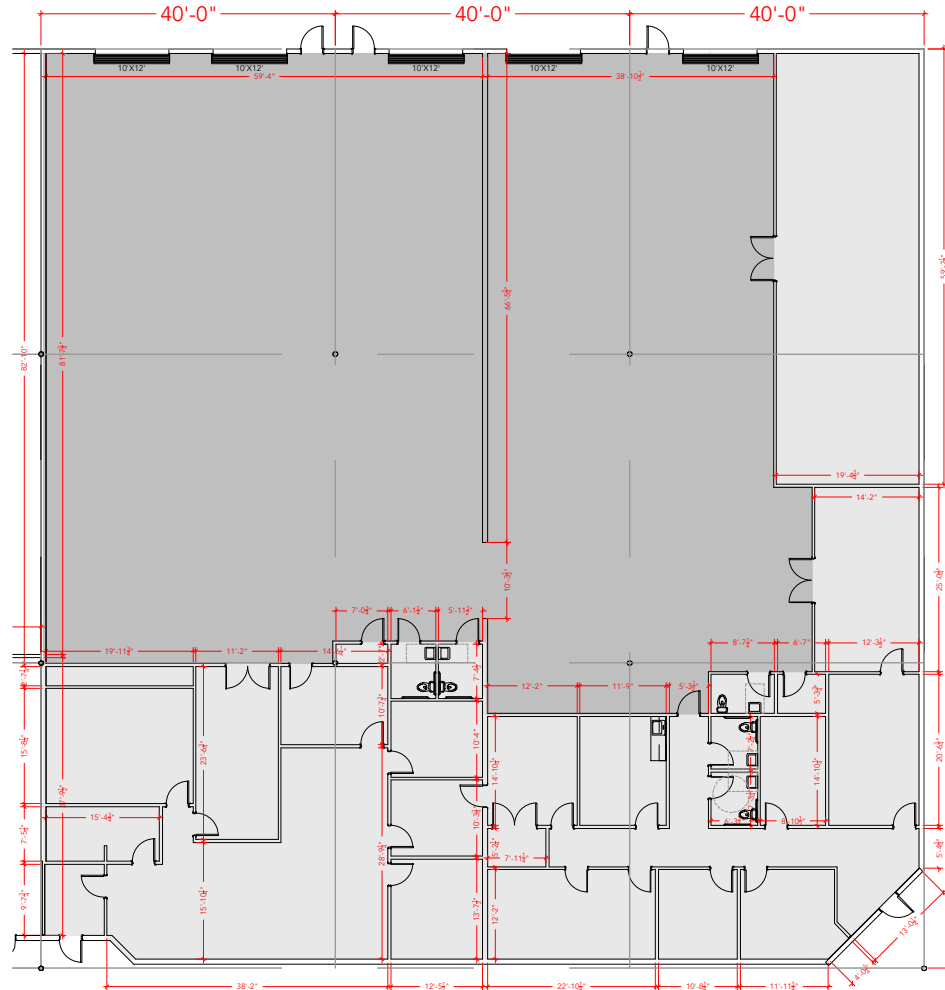

**Floor Plan**