

**TOTAL SF AVAILABLE -30,000 SF**


**OFFICE - 11,458 SF**

**WAREHOUSE - 18,542 SF**

[Click to access CADD file](#)



**Key Plan**

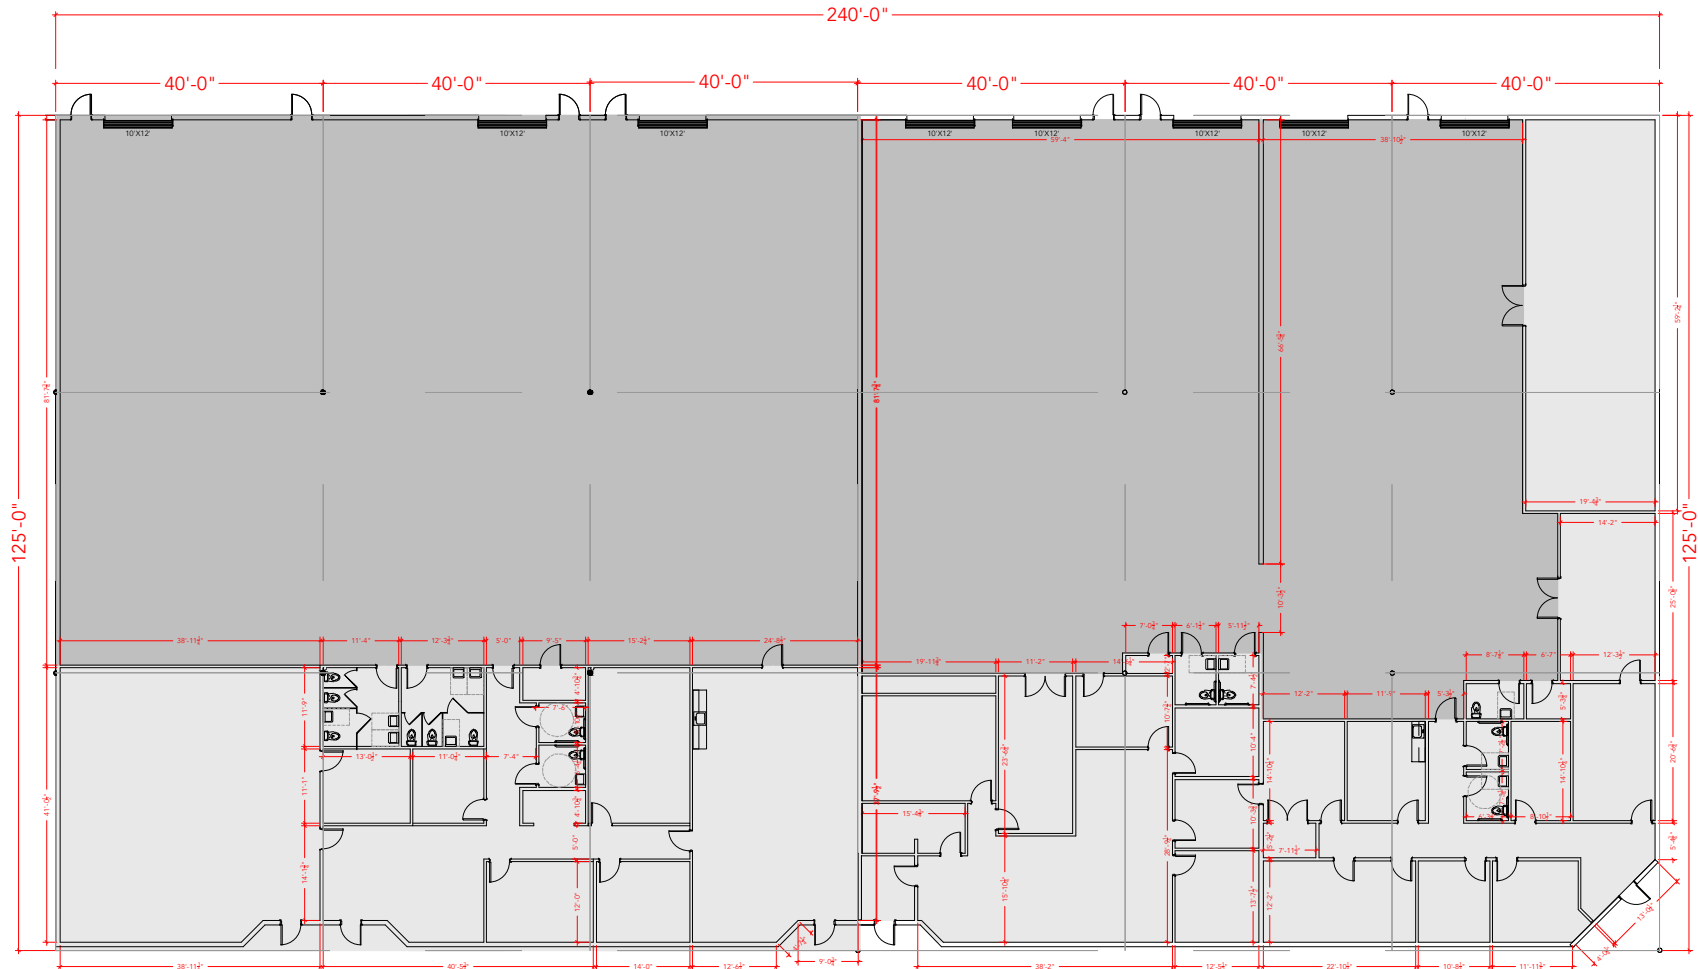

**Floor Plan**