

TOTAL SF AVAILABLE -15,000 SF


OFFICE - 5,098 SF

WAREHOUSE - 9,902 SF

[Click to access CADD file](#)



Key Plan

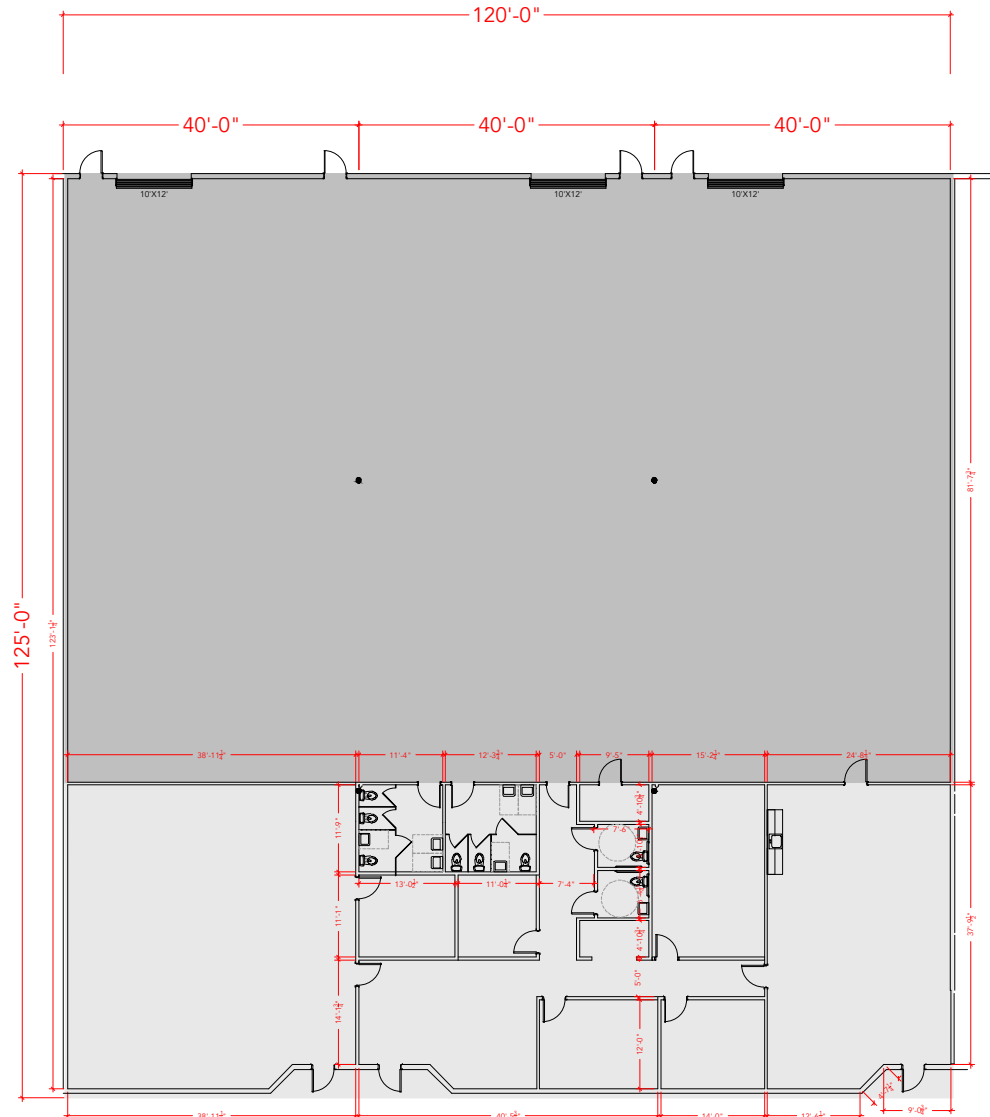

Floor Plan