


TOTAL SF AVAILABLE -2,690 RSF



Key Plan

101      102

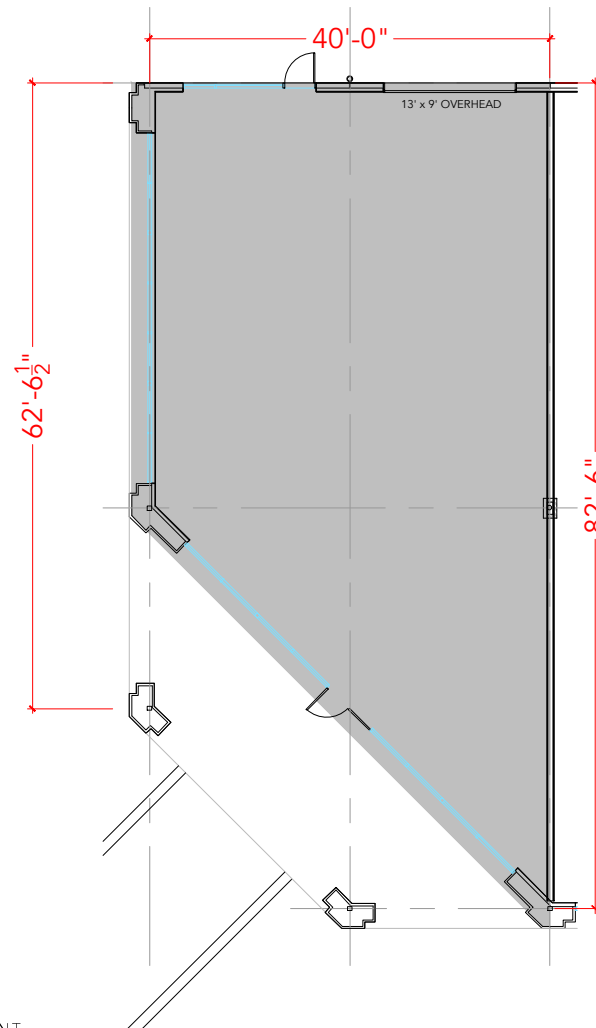

Floor Plan