



TOTAL SF AVAILABLE -3,397 RSF

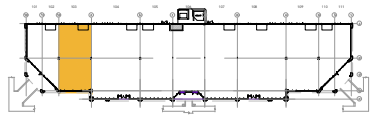

103

Key Plan

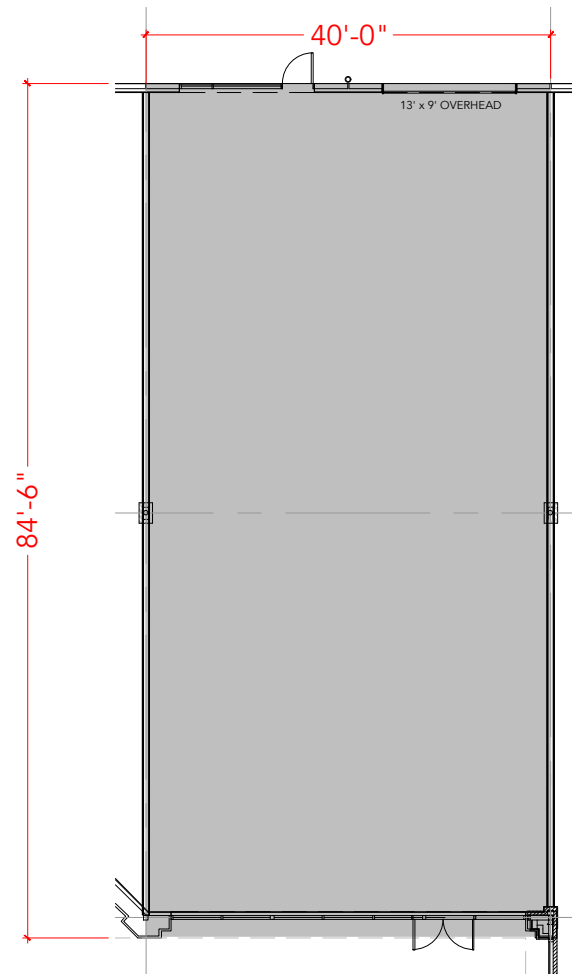

Floor Plan