


104

TOTAL SF AVAILABLE -5,677 RSF

Key Plan

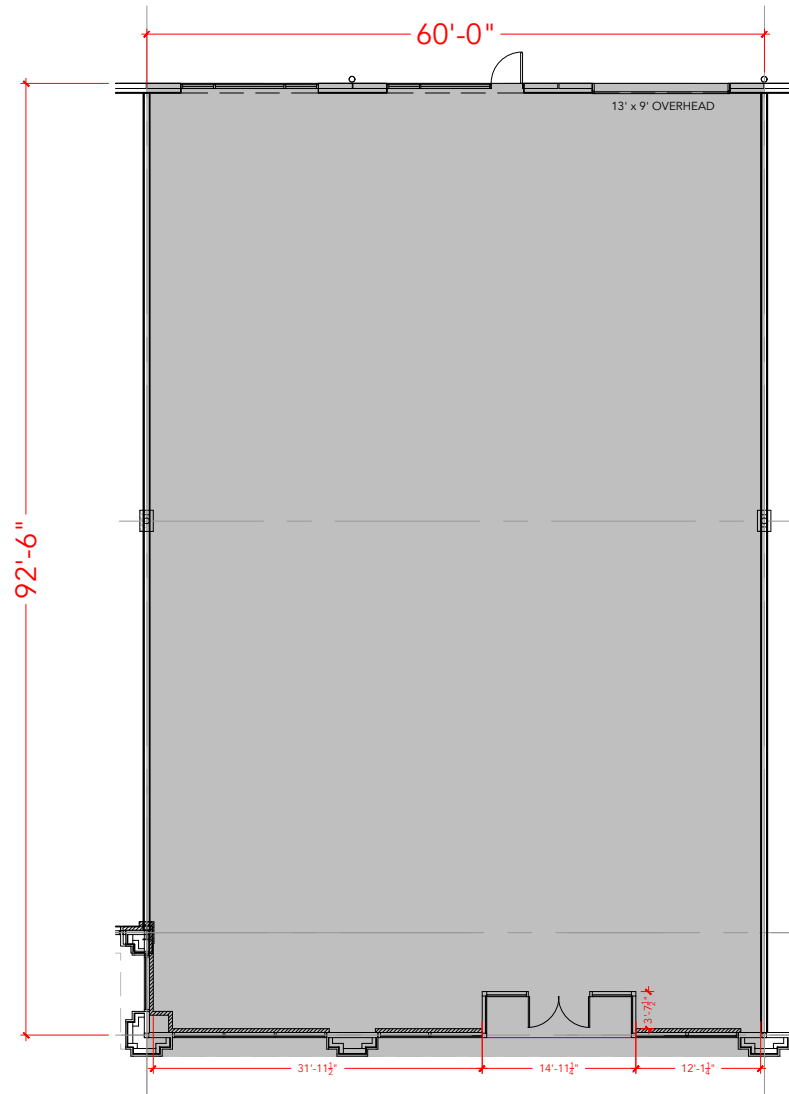

Floor Plan