



TOTAL SF AVAILABLE -5,556 RSF

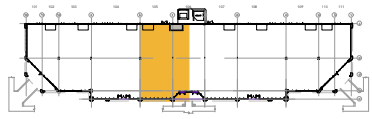

Key Plan

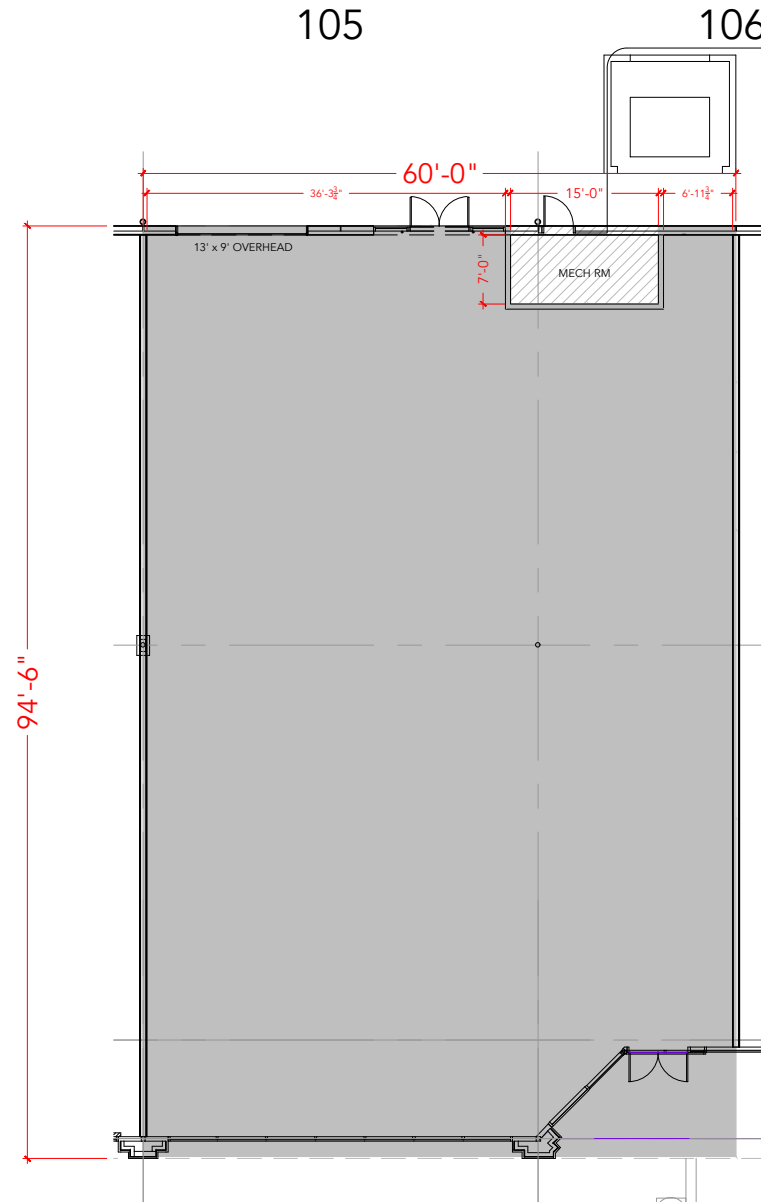

Floor Plan