



TOTAL SF AVAILABLE -5,677 RSF

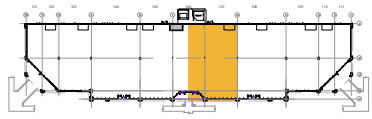

Key Plan

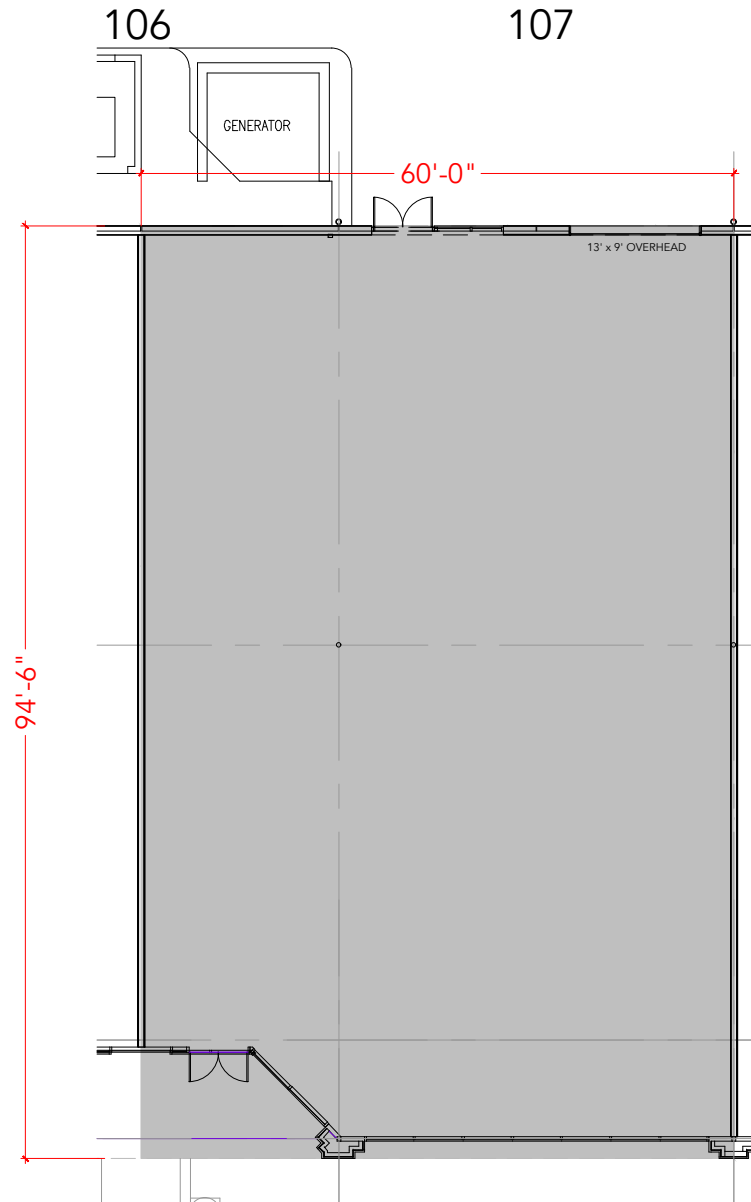

Floor Plan