



TOTAL SF AVAILABLE -5,677 RSF

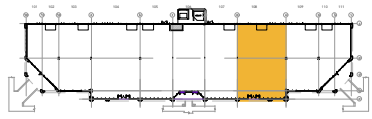

108

Key Plan

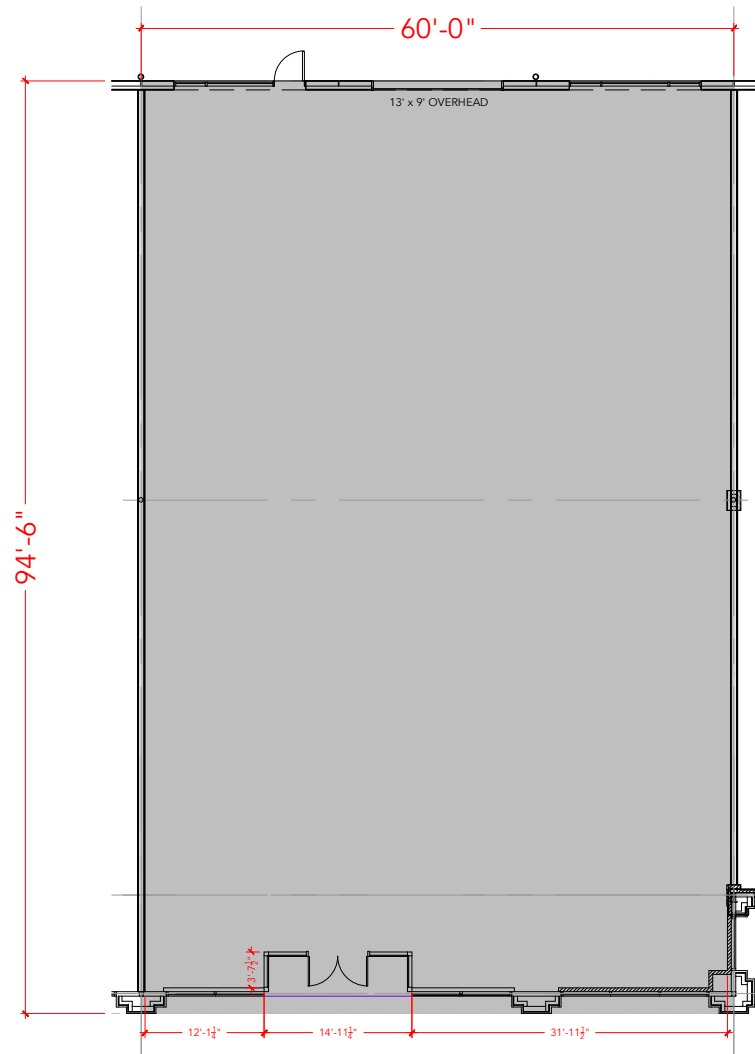

Floor Plan