



TOTAL SF AVAILABLE -3,397 RSF

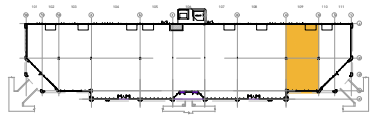

109

Key Plan

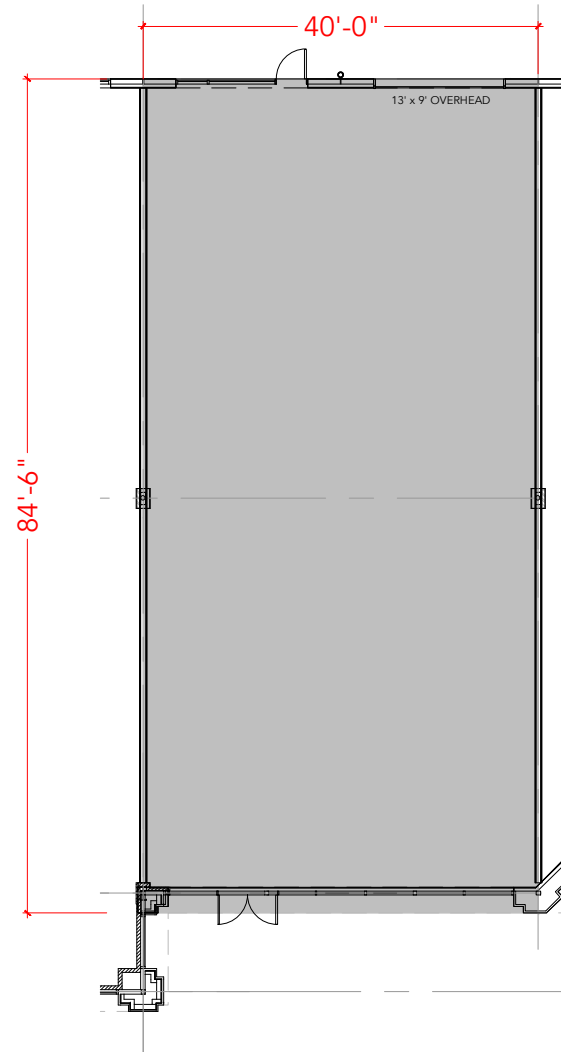

Floor Plan