



TOTAL SF AVAILABLE -2,690 RSF

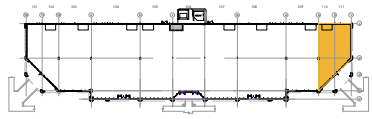

110

111

Key Plan

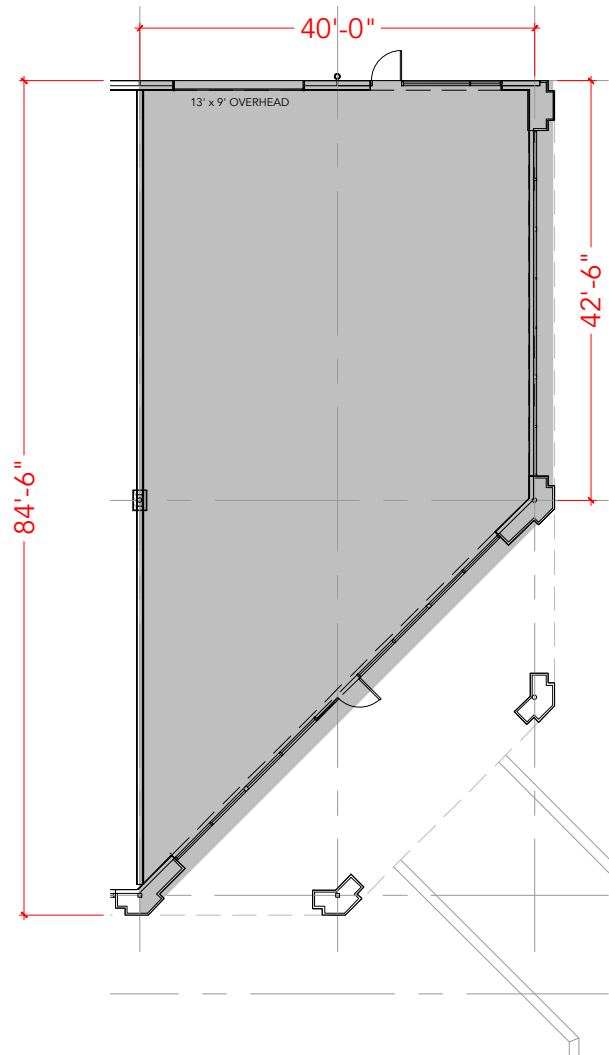

Floor Plan