



TOTAL SF AVAILABLE -9,317 RSF

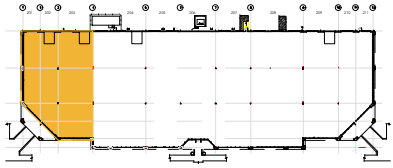

Key Plan

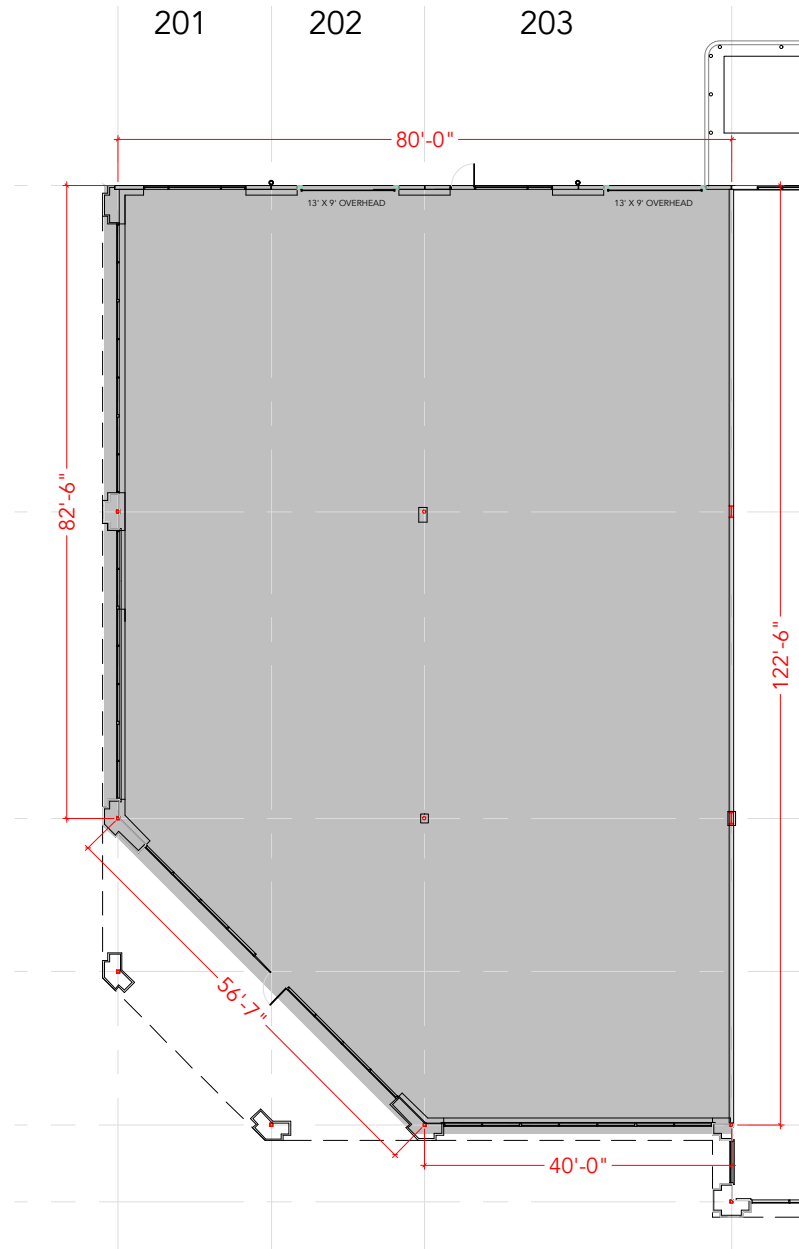

Floor Plan