


TOTAL SF AVAILABLE -8,089 RSF



Key Plan

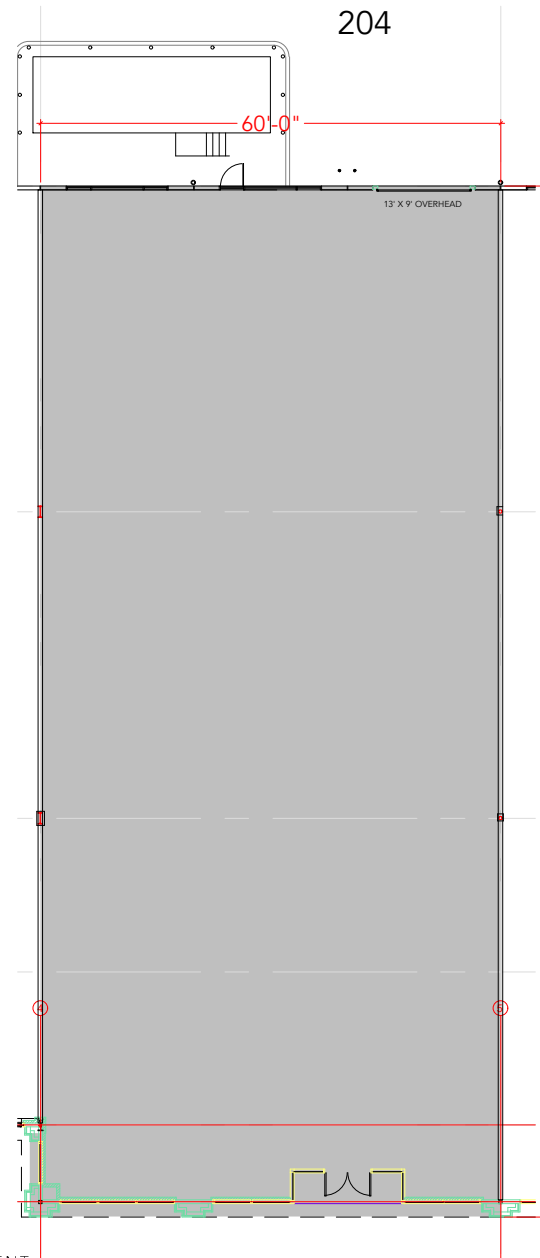

Floor Plan