


TOTAL SF AVAILABLE -8,076 RSF



Key Plan

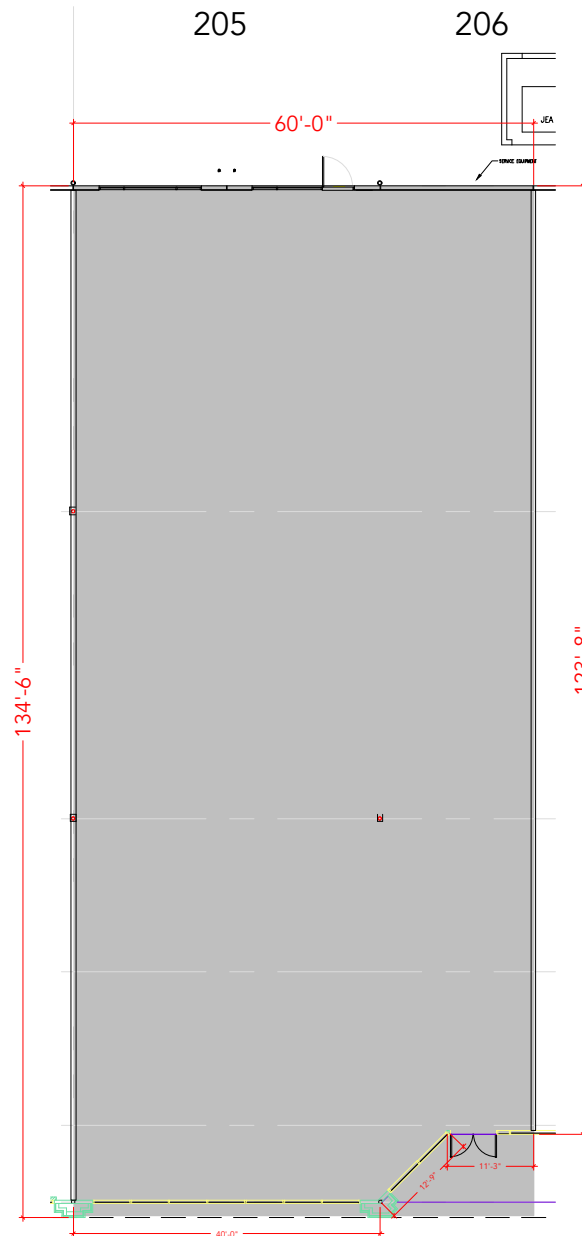

Floor Plan