



TOTAL SF AVAILABLE -7,963 RSF

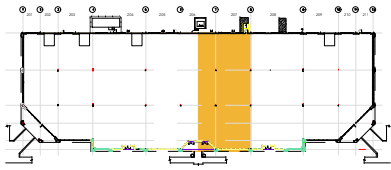

Key Plan

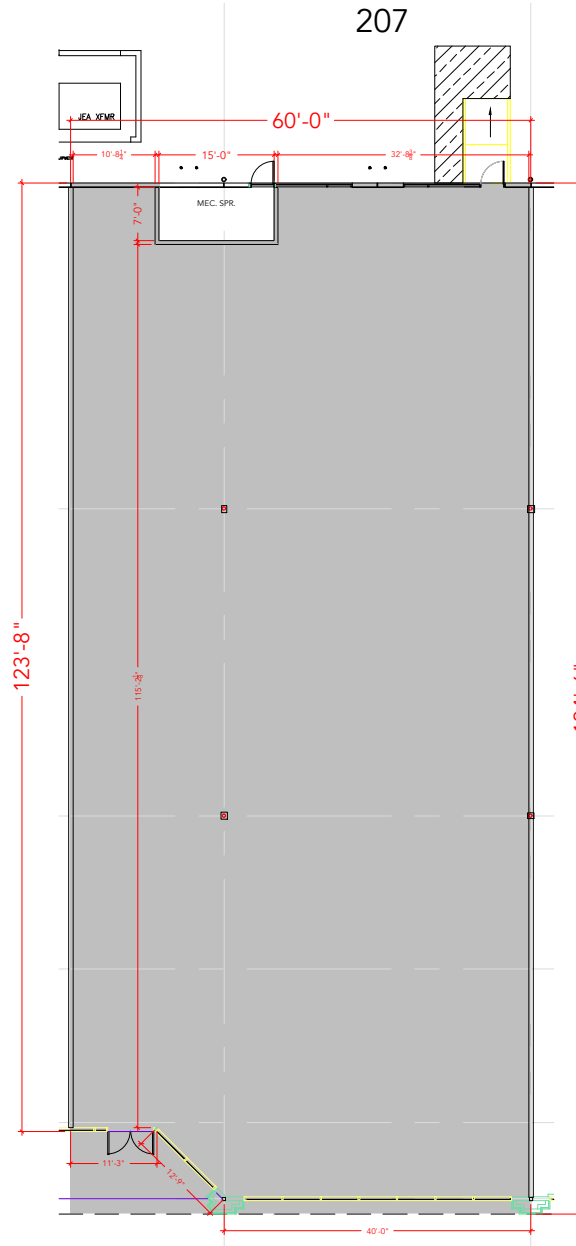

Floor Plan