



TOTAL SF AVAILABLE -8,070 RSF

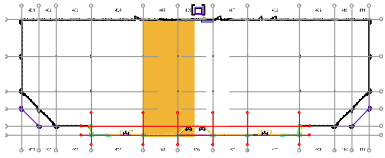

Key Plan

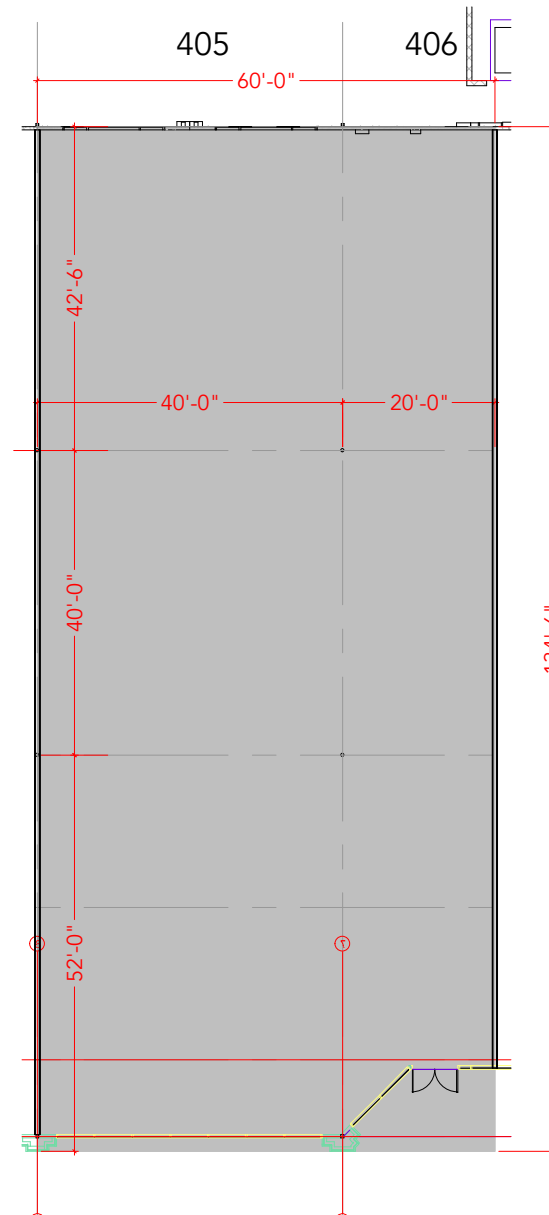

Floor Plan