



TOTAL SF AVAILABLE -8,095 RSF

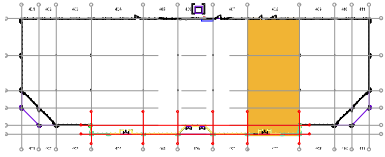

Key Plan

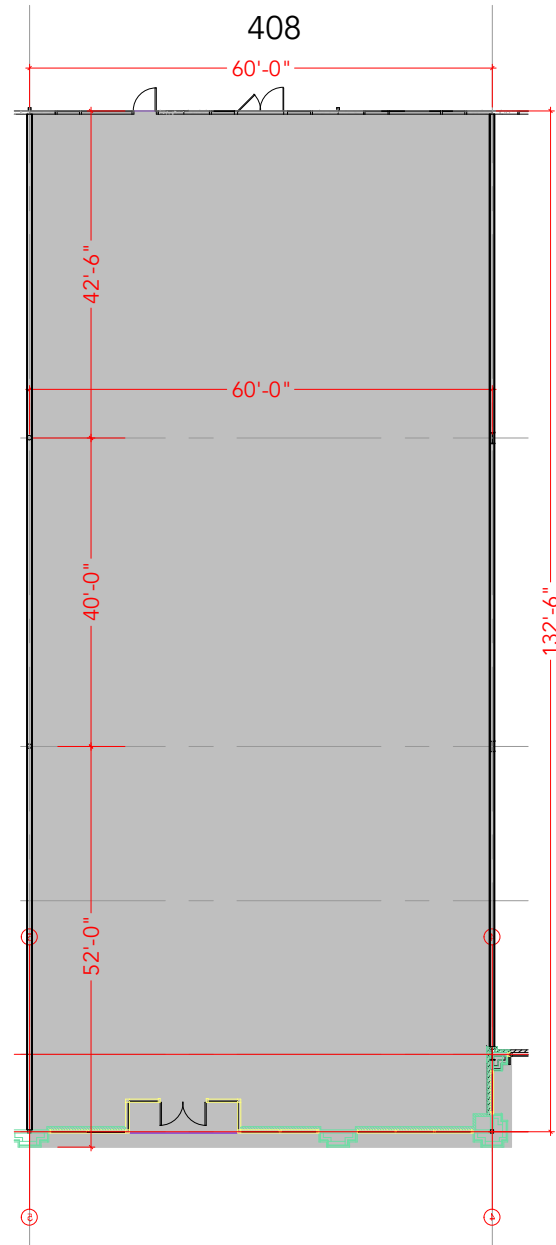

Floor Plan