



TOTAL SF AVAILABLE -9,361 RSF

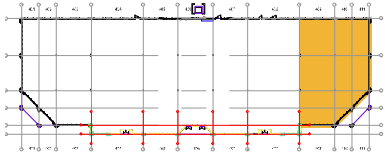

Key Plan

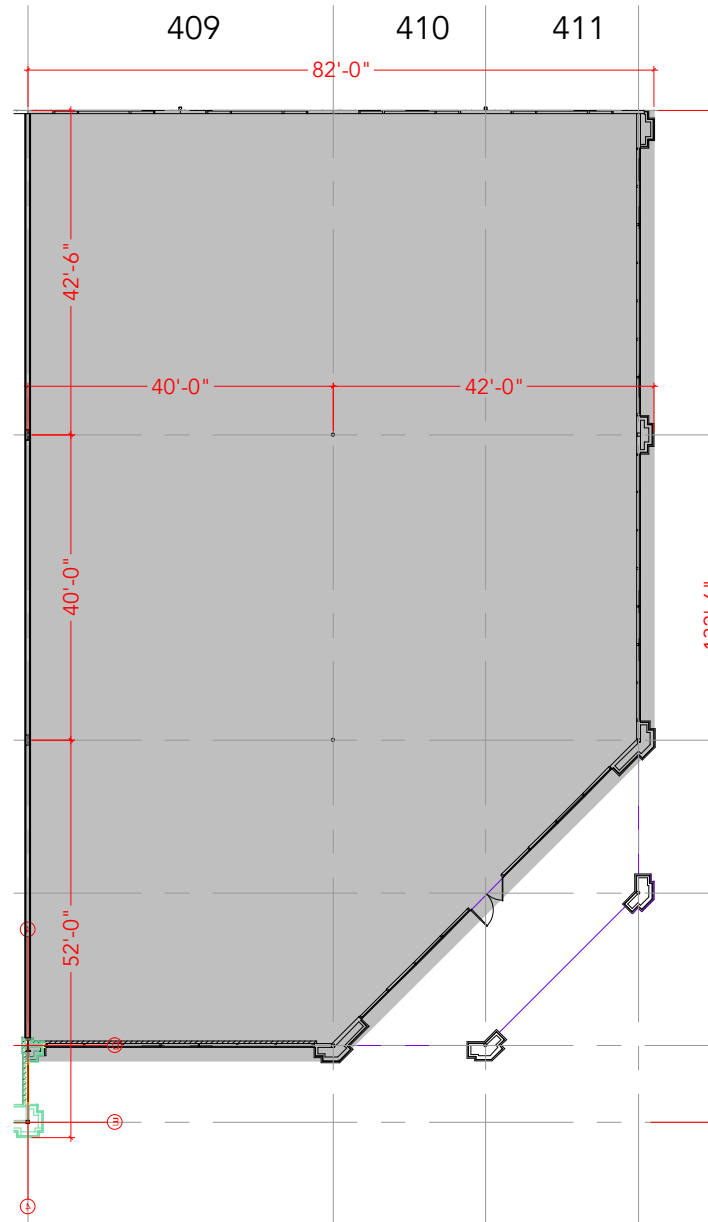

Floor Plan