


Key Plan

TOTAL SF AVAILABLE -3,036 RSF

OFFICE - 0 RSF

WAREHOUSE - 3,036 RSF

[Click to access CADD file](#)

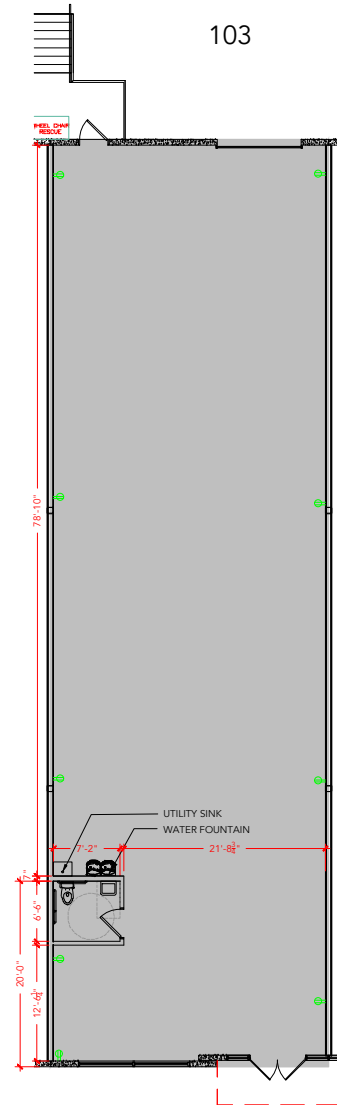

Floor Plan