



TOTAL SF AVAILABLE - 5,604 RSF

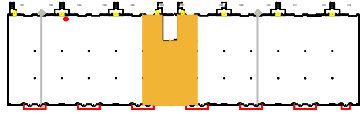

Key Plan

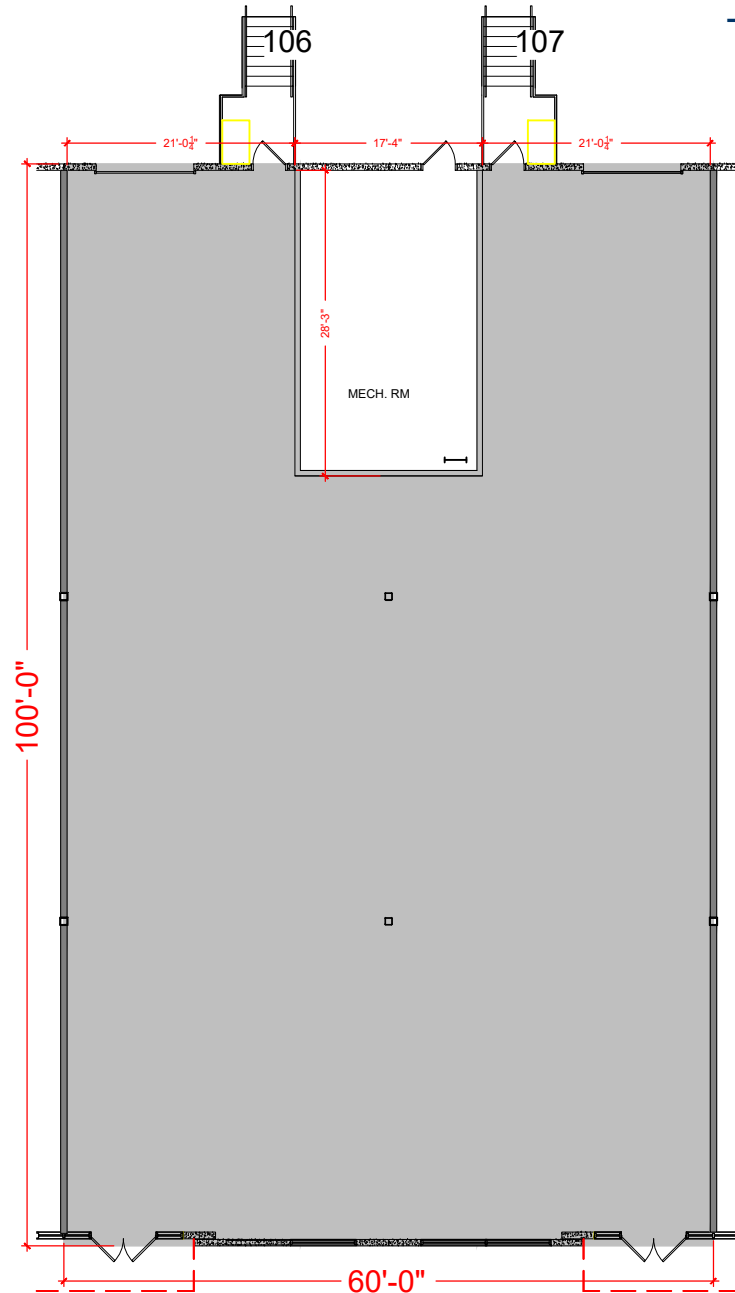

Floor Plan