


Key Plan

TOTAL SF AVAILABLE - 6,573 RSF

OFFICE - 799 RSF

WAREHOUSE - 5,774 RSF

[Click to access CADD file](#)

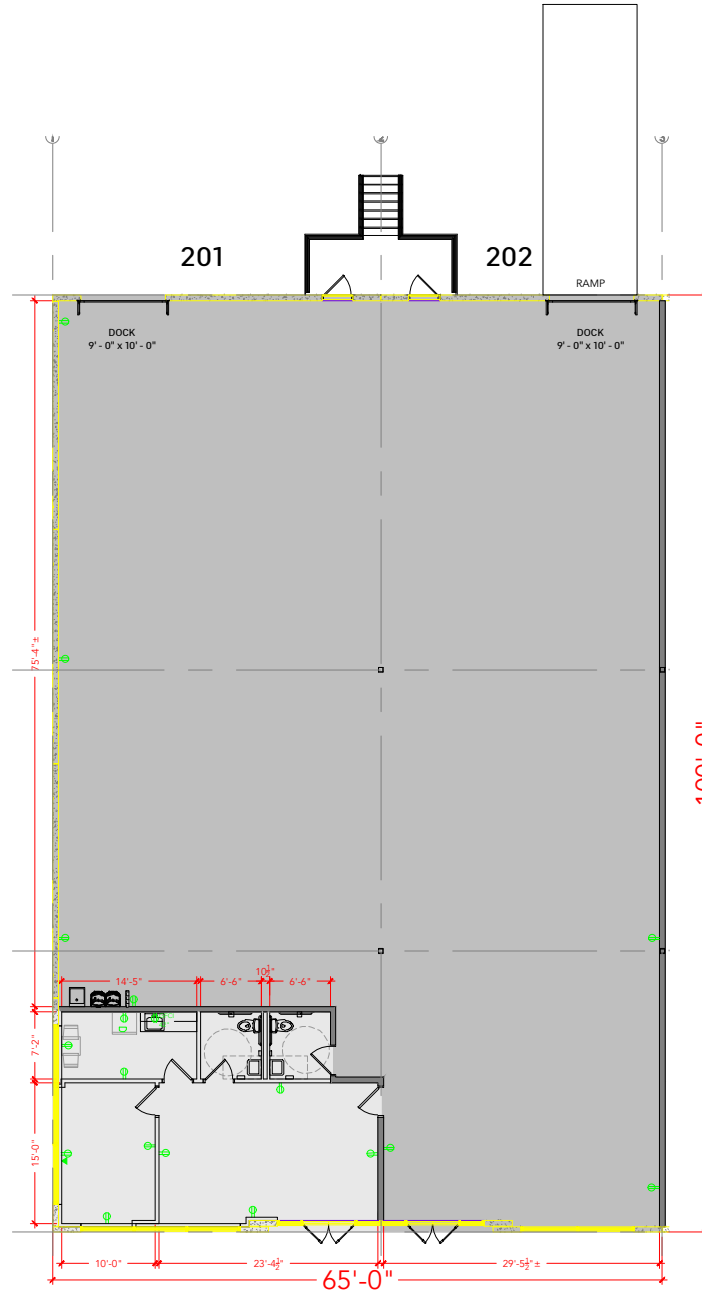

Floor Plan