



TOTAL SF AVAILABLE - 20,786 RSF

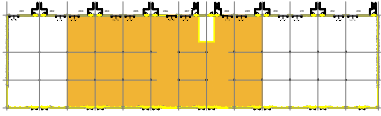

Key Plan

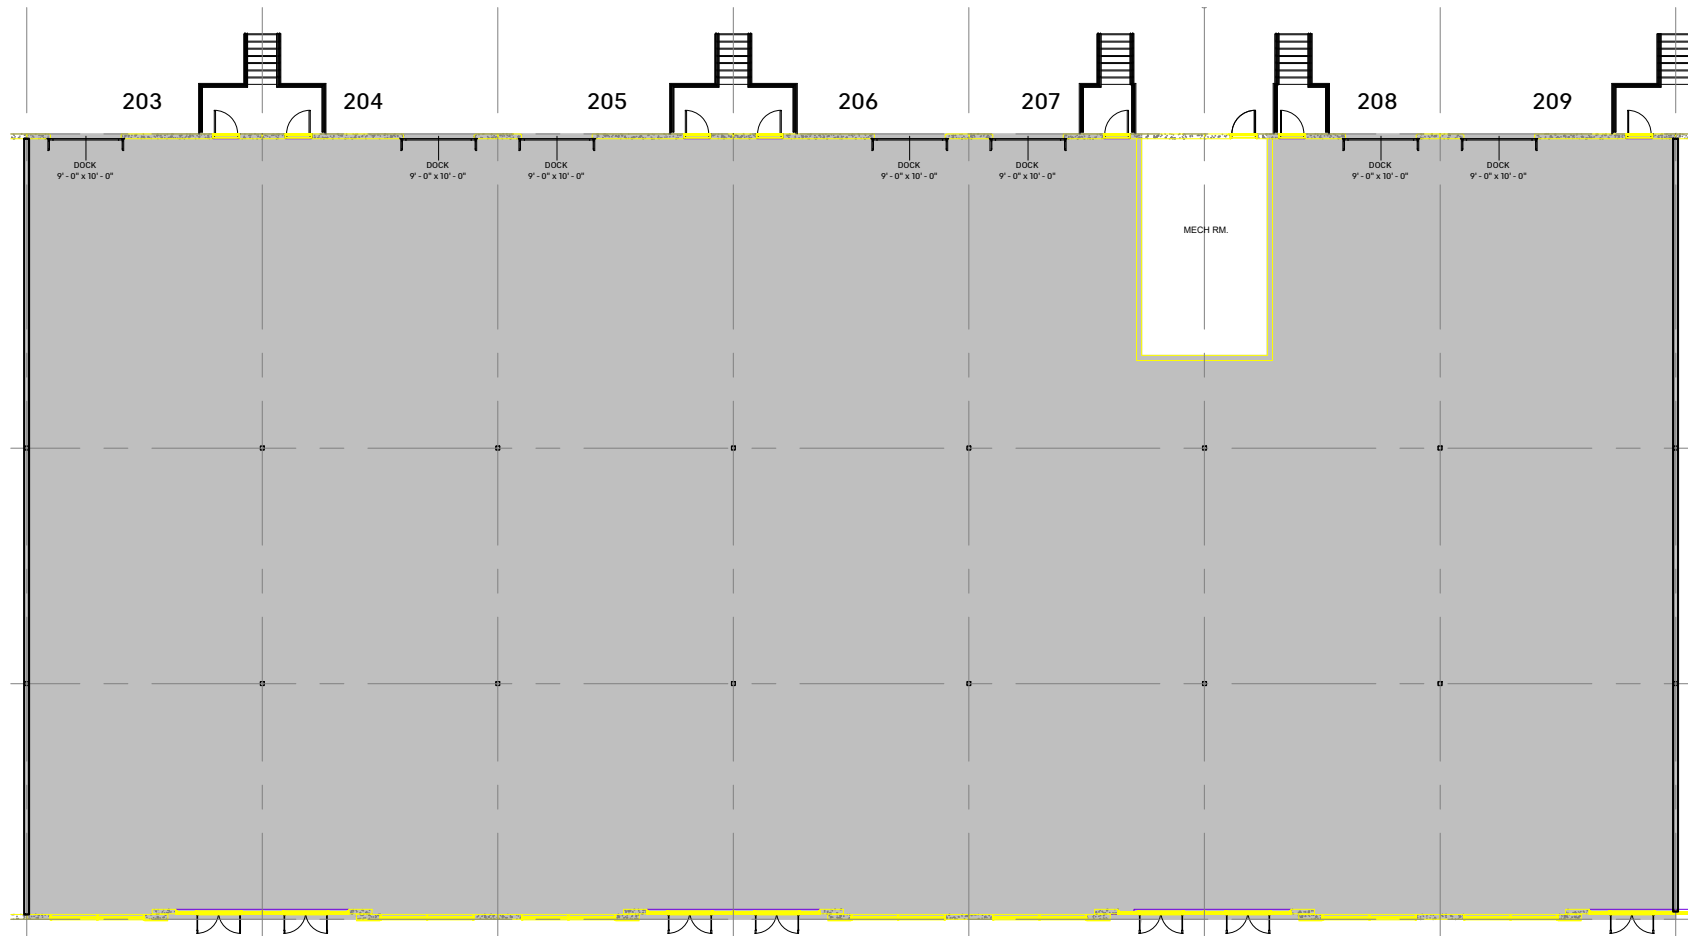

Floor Plan