



TOTAL SF AVAILABLE -3,034 RSF

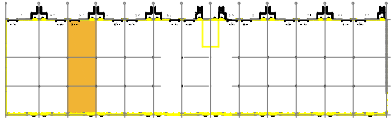

Key Plan

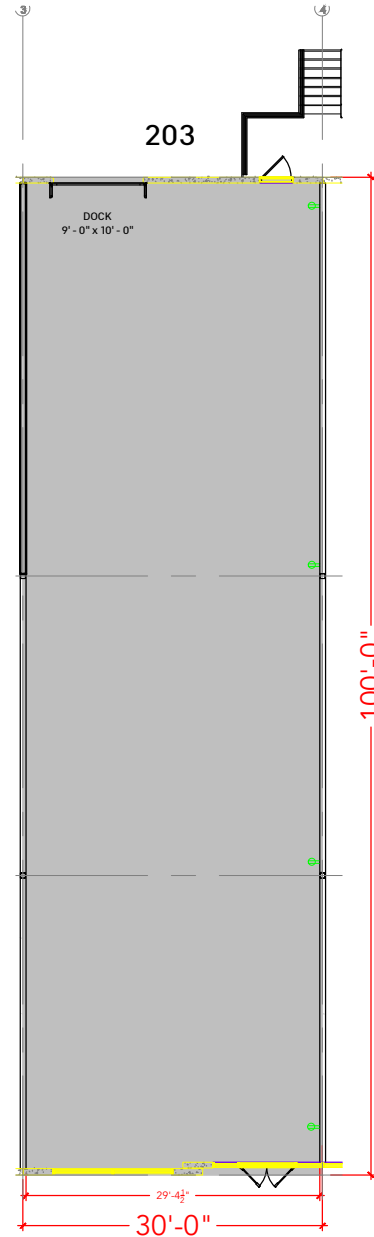

[Click to access CADD file](#)

Floor Plan