


Key Plan

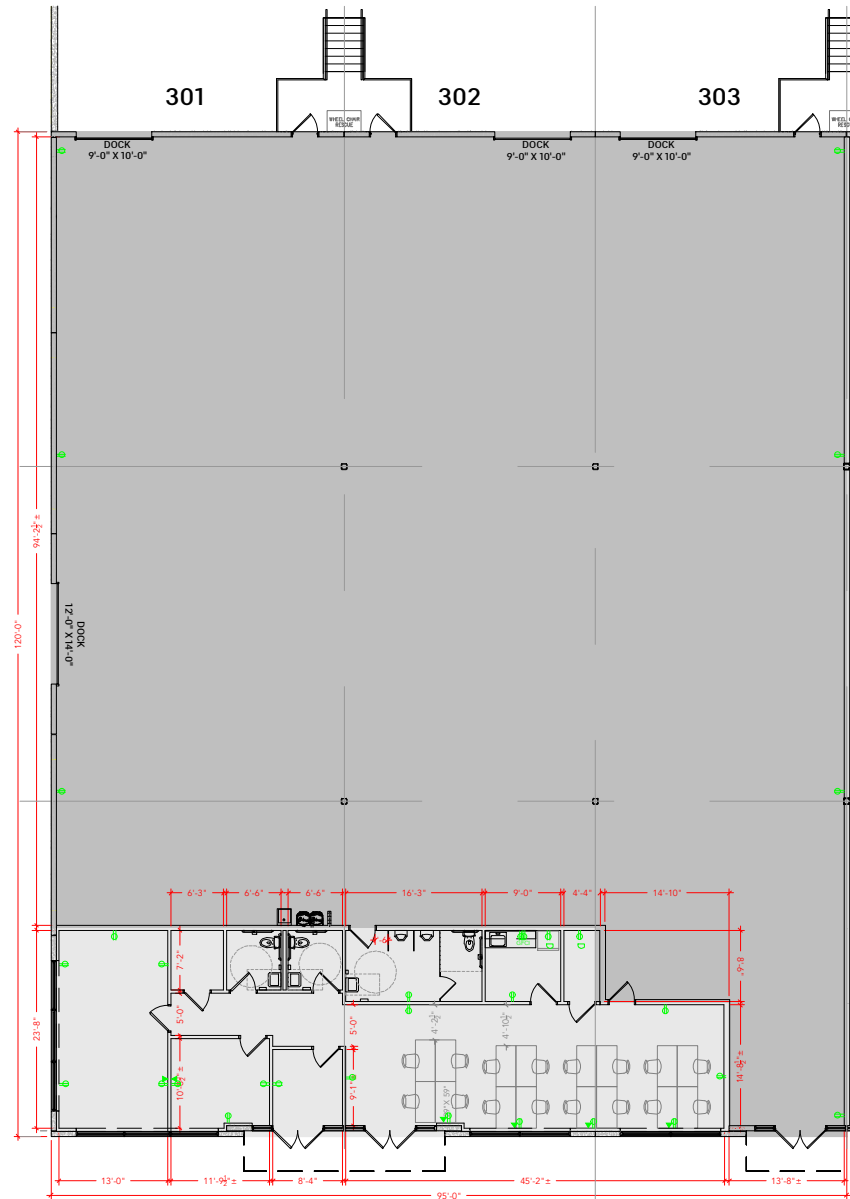

TOTAL SF AVAILABLE -11,488 RSF

OFFICE - 1,876 RSF

WAREHOUSE - 9,612 RSF

[Click to access CADD file](#)

Floor Plan